

# PLAT AND RECORD

COUNTY BUILDING  
CITY OF JANESVILLE

Of a Survey on Section **31** T **3** R **11** E. of the 4 P. M. in **CENTER** Township


Rock County, Wisconsin, made **AUGUST** the **14** 19**79**

I hereby certify that the following is a correct record of said survey as made by me,



## S 1/4 COR SEC 31

FOUND CUT LIMESTONE

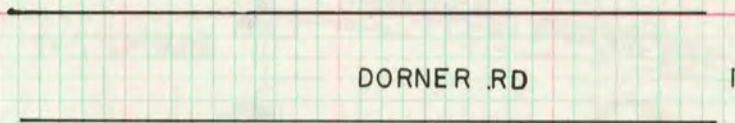

**MICROFILMED**

## SE COR SEC 31

DUG & FOUND NOTHING

