

COUNTY BUILDING  
CITY OF JANESVILLE

# PLAT AND RECORD

565  
V-4

COUNTY BUILDING  
CITY OF JANESVILLE

Of a Survey on Section 19 T 3 R 11 E. of the 4 P. M. in Center Township


Rock County, Wisconsin, made June the 5th 19 72

I hereby certify that the following is a correct record of said survey as made by me.

**MICROFILMED**

*Hugh J. Lee*  
County Surveyor.

THE GEO. D. BARNARD COMPANY, ST. LOUIS

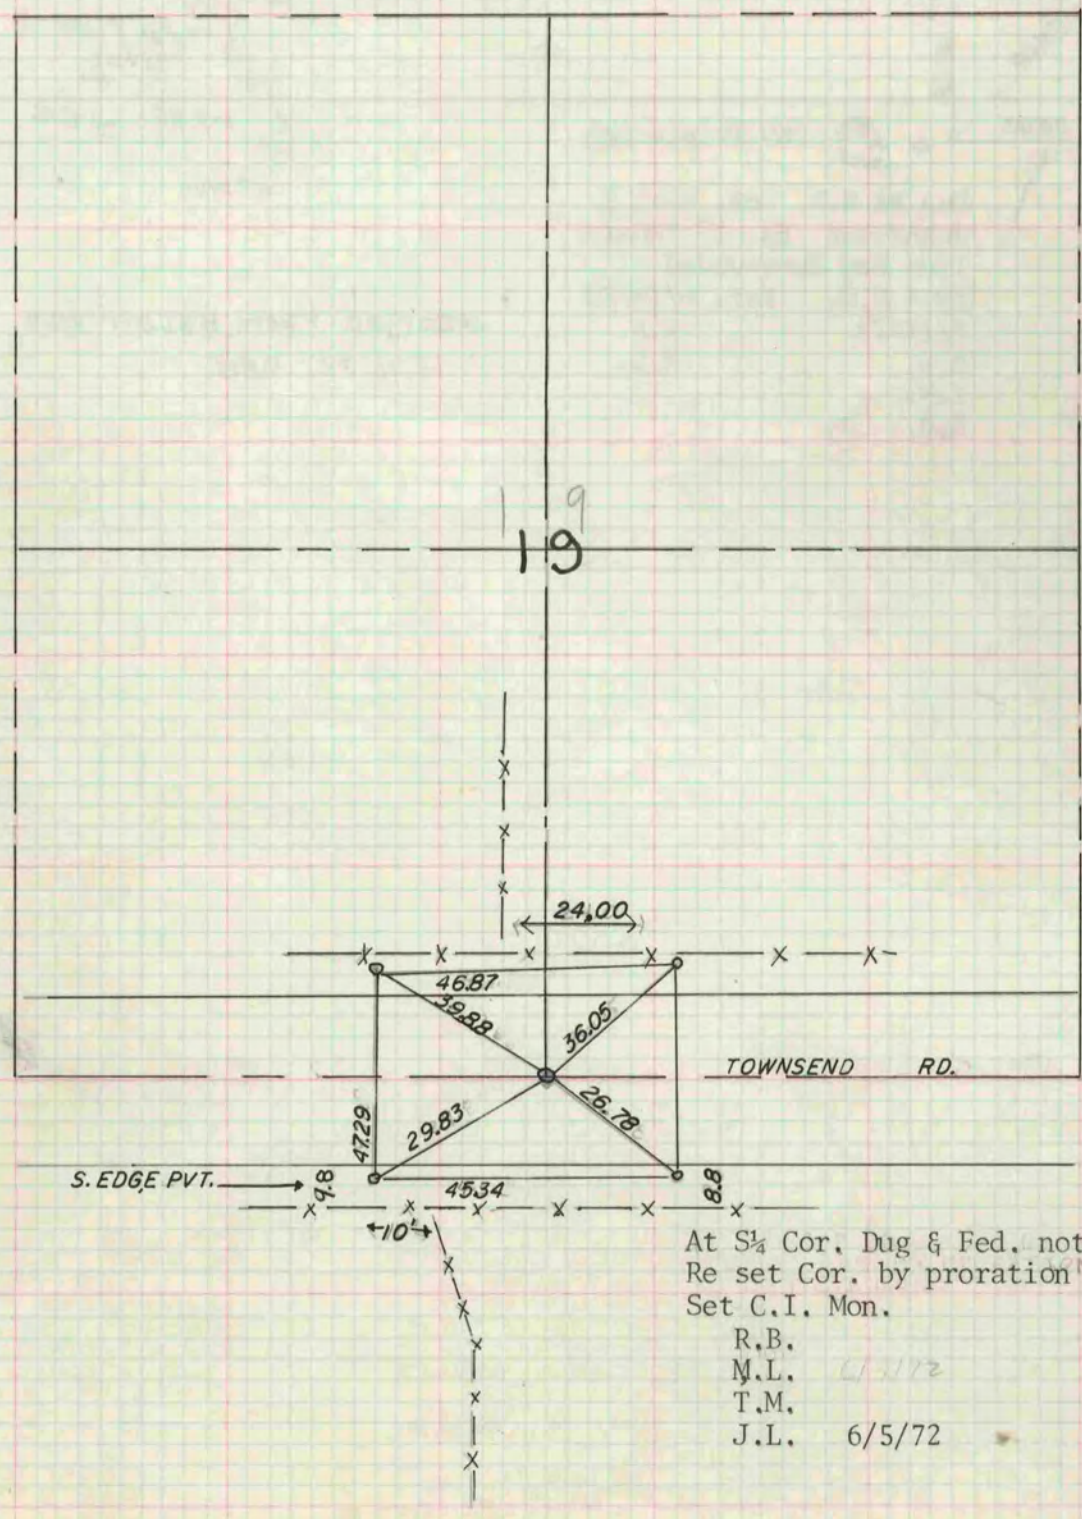

At S $\frac{1}{4}$  Cor. Dug & Fed. nothing  
 Re set Cor. by proration<sup>N</sup>  
 Set C.I. Mon.  
 R.B.  
 M.L. 7/3/72  
 T.M.  
 J.L. 6/5/72