

# PLAT AND RECORD


**MICROFILMED**

Of a Survey on Section 3 T 1 R 13 E. of the 4 P. M. in Turtle Township  
Rock County, Wisconsin, made March the 9th 1861

I hereby certify that the following is a correct record of said survey as made by me.

COUNTY BUILDING  
CITY OF JANESVILLE

(Signed) Edward Ruger  
R. H. B. County Surveyor.

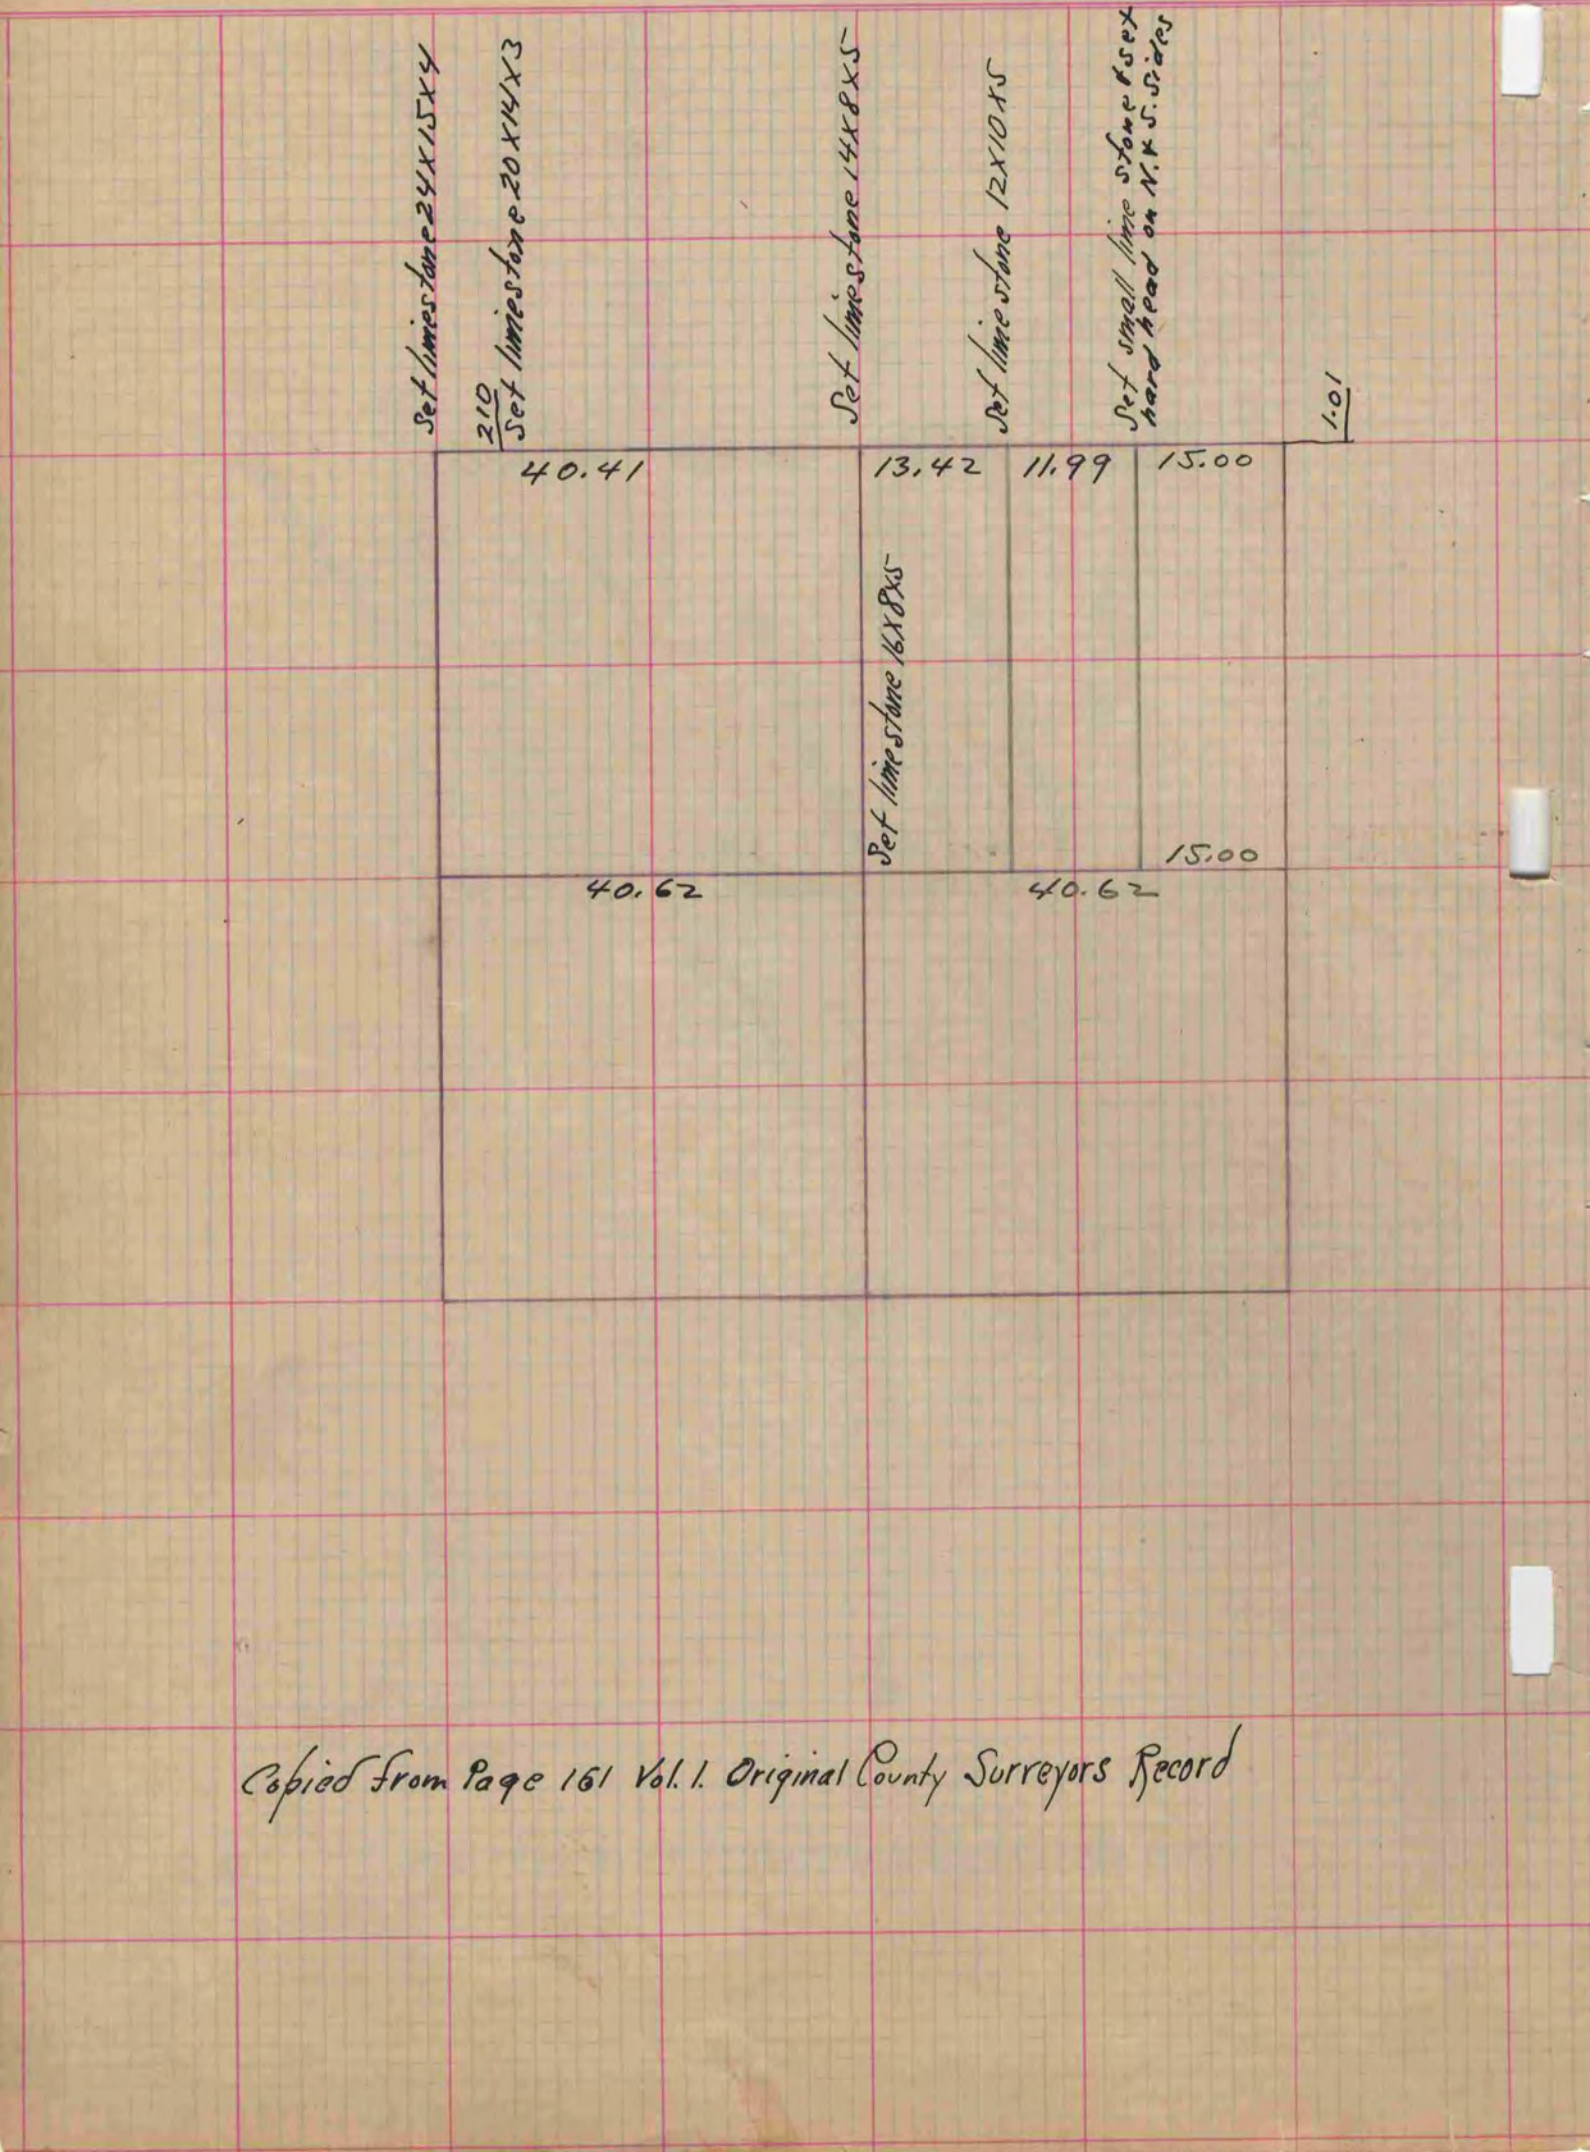

*Copied from Page 161 Vol. 1. Original County Surveyors Record*