

MICROFILMED

PLAT AND RECORD

115
V-2


COUNTY BUILDING
CITY OF JANESVILLE

Of a Survey on Section 25 T 2 R 11 E. of the 4 P. M. in Plymouth Township

Rock County, Wisconsin, made November the 25 & 26 1873

I hereby certify that the following is a correct record of said survey as made by me.

(Signed) Edward Ruger
R. H. B. County Surveyor.

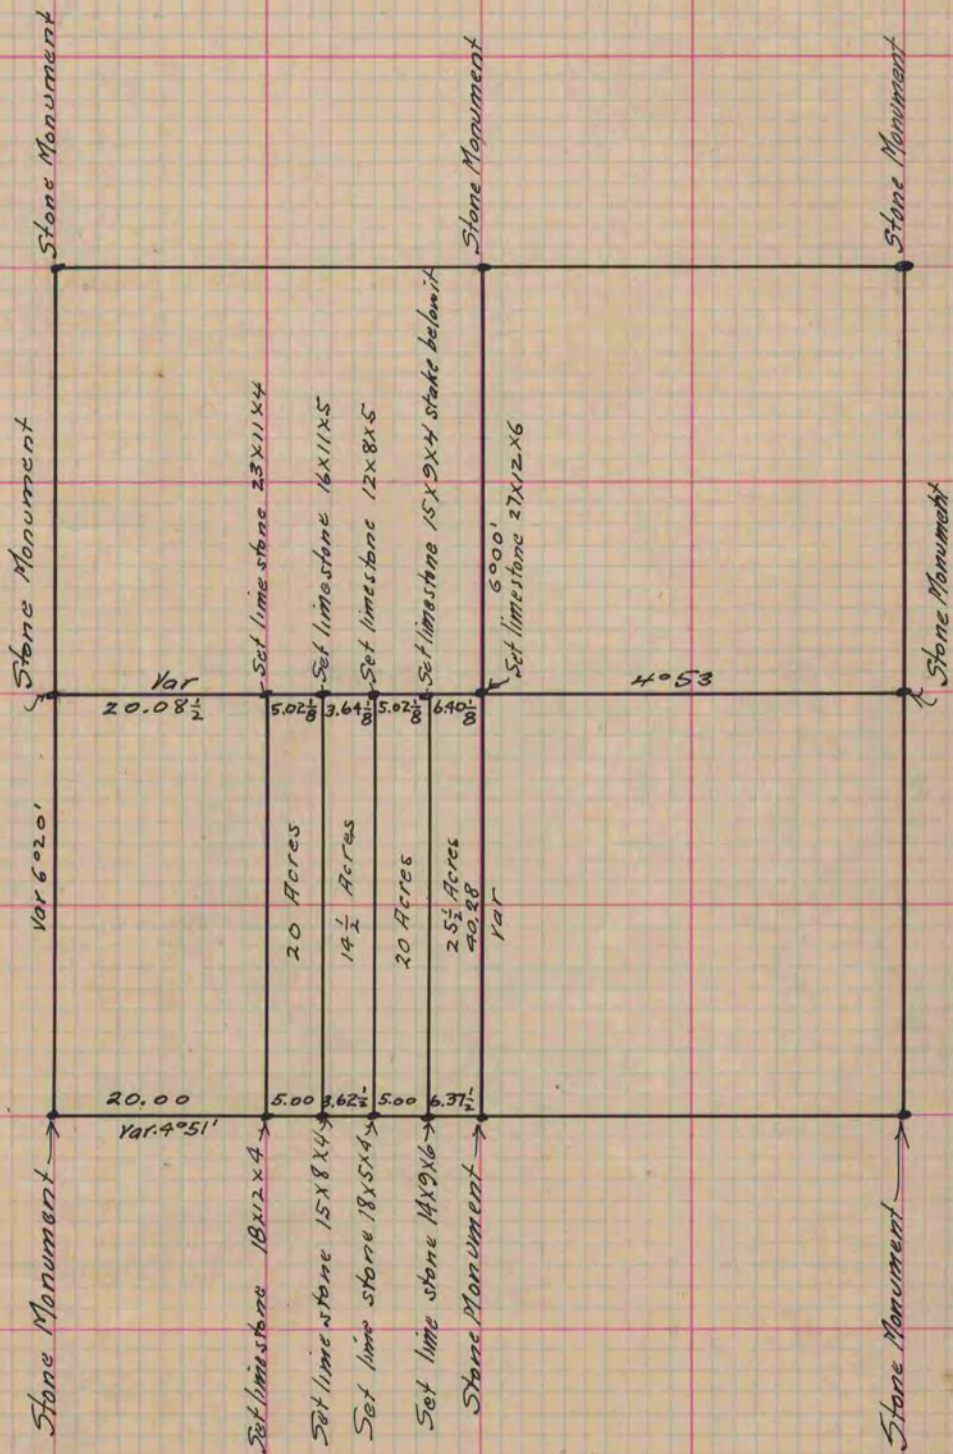

Copied from Page 73 Vol. 2 Original County Surveyors Record