

PLAT AND RECORD

125
VOL. 6

Of a Survey on Section **33** T **2** R **11** E. of the 4 P. M. in **PLYMOUTH** Township
Rock County, Wisconsin, made **OCT** the **10** 1879.


I hereby certify that the following is a correct record of said survey as made by me.

COUNTY BUILDING
CITY OF JANESVILLE



NE COR SEC 33

DUG 30" DEEP AND FOUND OLD STONE RD BED. DUG 30" DEEPER THRU SAND AND FOUND NOTHING. SET ALUM MON SET AS CALLED OUT IN LOCKE'S REMONUMENTATION NOTES IN REGARDS TO THE CENTER OF THE ROAD. THIS WAS IN HARMONY WITH THE RECORD DISTANCES.

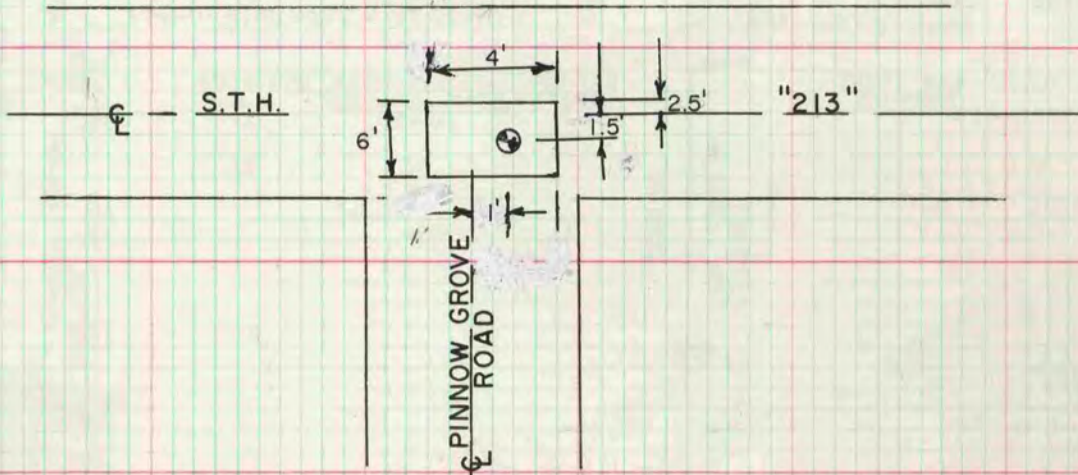

MICROFILMED

NE 1/4 COR SEC 33

SET ALUM MON AT SINGLE PROPORTIONATE MEASUREMENT FROM THE NE & NW CORNER OF SEC 33. USED RUGER'S PRORATED DISTANCE FROM THE CENTER OF THE SECTION TO CONTROL THE N/S POSITION. LOCKE'S REMONUMENTATION NOTES STATES THE CORNER WAS IN THE CENTER OF THE OLD ROAD AND THE VAR INDICATES THE CORNER IS NOT ON A STRAIGHT LINE BETWEEN THE NE & NW CORNER OF SEC 33. THE TERRIAN INDICATES A LARGE ROAD CUT. DUG 36" DEEP AND FOUND SAND BUT NOT THE OLD ROAD BED AS FOUND AT THE NW & NE CORNERS. SABB WAS FOUND UNDER THE OLD ROAD AT THESE CORNERS. IF PLACED ON A STRAIGHT LINE THE CORNER WOULD BE FURTHER SOUTH 5 FEET. IF SET AT THE CENTERLINE OF THE EXISTING ROAD, THE DIFFERENCE IN BEARING BETWEEN THE NW & NE CORNER WOULD BE 0°05'28". THE RECORD DIFFERENCE IN BEARINGS ARE:

RUGER (1871)	0°18'
LOCKE (1868)	0°10'
AS SET	0°12'33"
IF AT CENTER OF PVMT	0°5'28"

