

# PLAT AND RECORD

**MICROFILMED**


COUNTY BUILDING  
CITY OF JANESVILLE

Of a Survey on Section 6 T 2 R 12 E. of the 4 P. M. in Rock Township

Rock County, Wisconsin, made July the 9<sup>th</sup> 1866

I hereby certify that the following is a correct record of said survey as made by me.

(Signed) S. D. Locke  
R. I. B. County Surveyor.

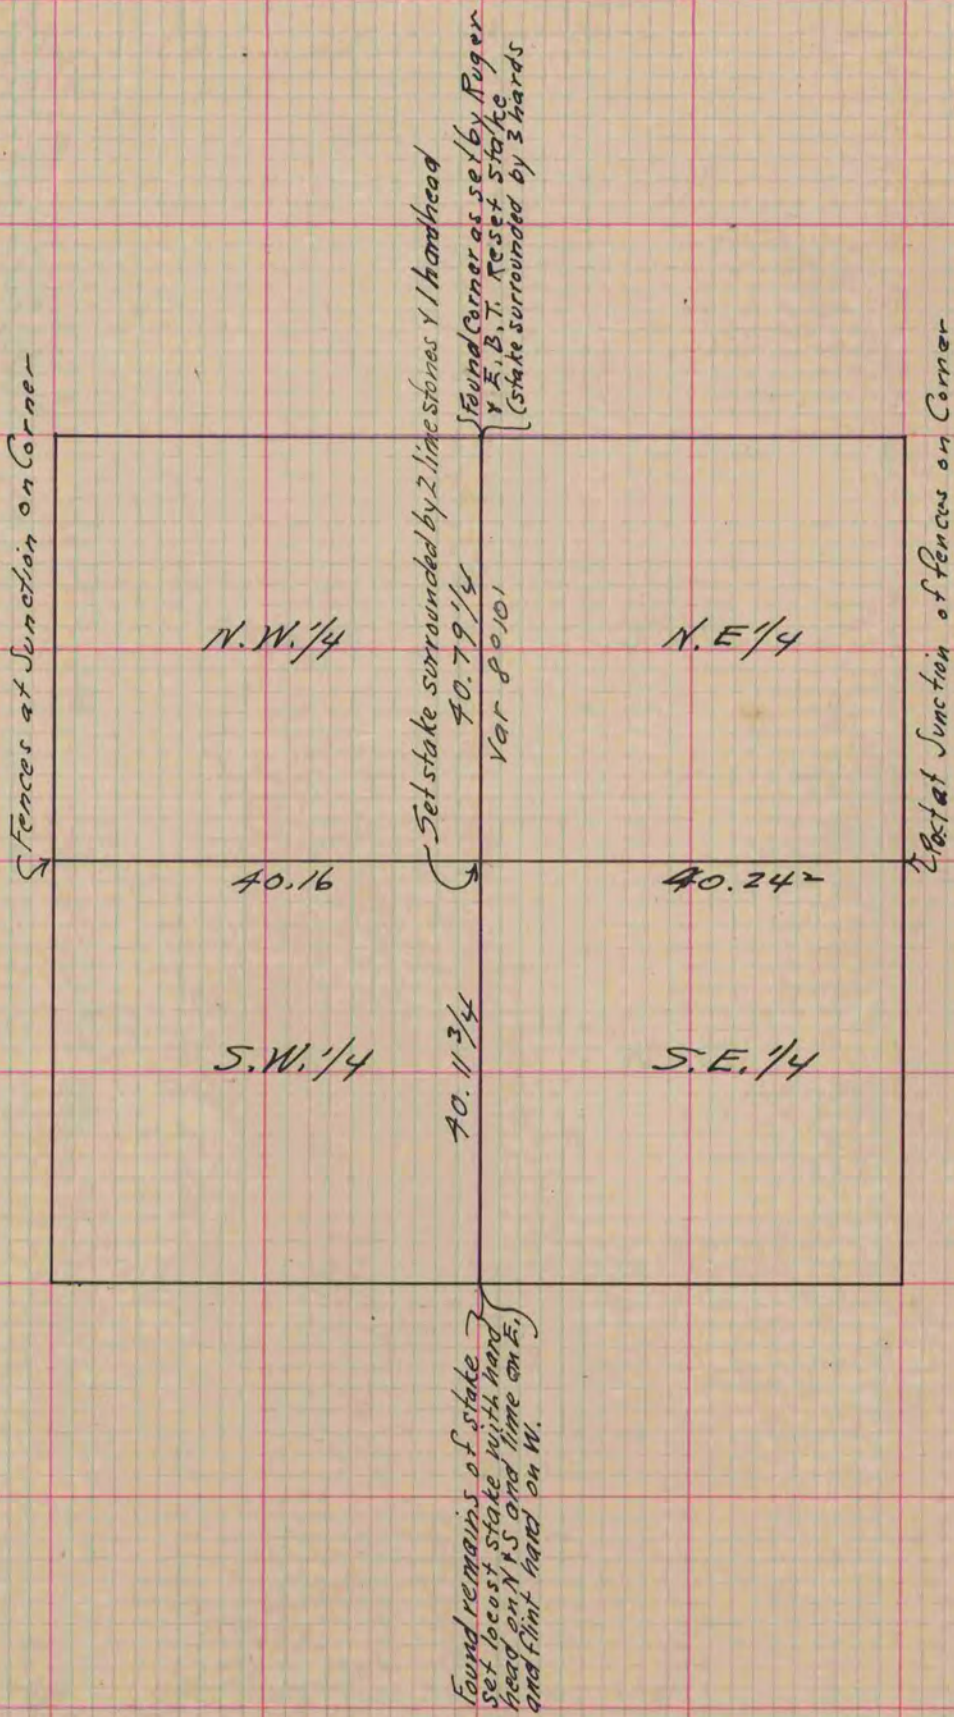

Copied from lower 1/2 of Page 236 Vol. 1. Original County Surveyors Record