

PLAT AND RECORD

MICROFILMED

Of a Survey on Section 25 T 3 R 14 E. of the 4 P. M. in Johnstown Township


Rock County, Wisconsin, made April the 26 1900

I hereby certify that the following is a correct record of said survey as made by me.

COUNTY BUILDING
CITY OF JANESVILLE

(Signed) P.F. Brown
R.H.B.

County Surveyor.

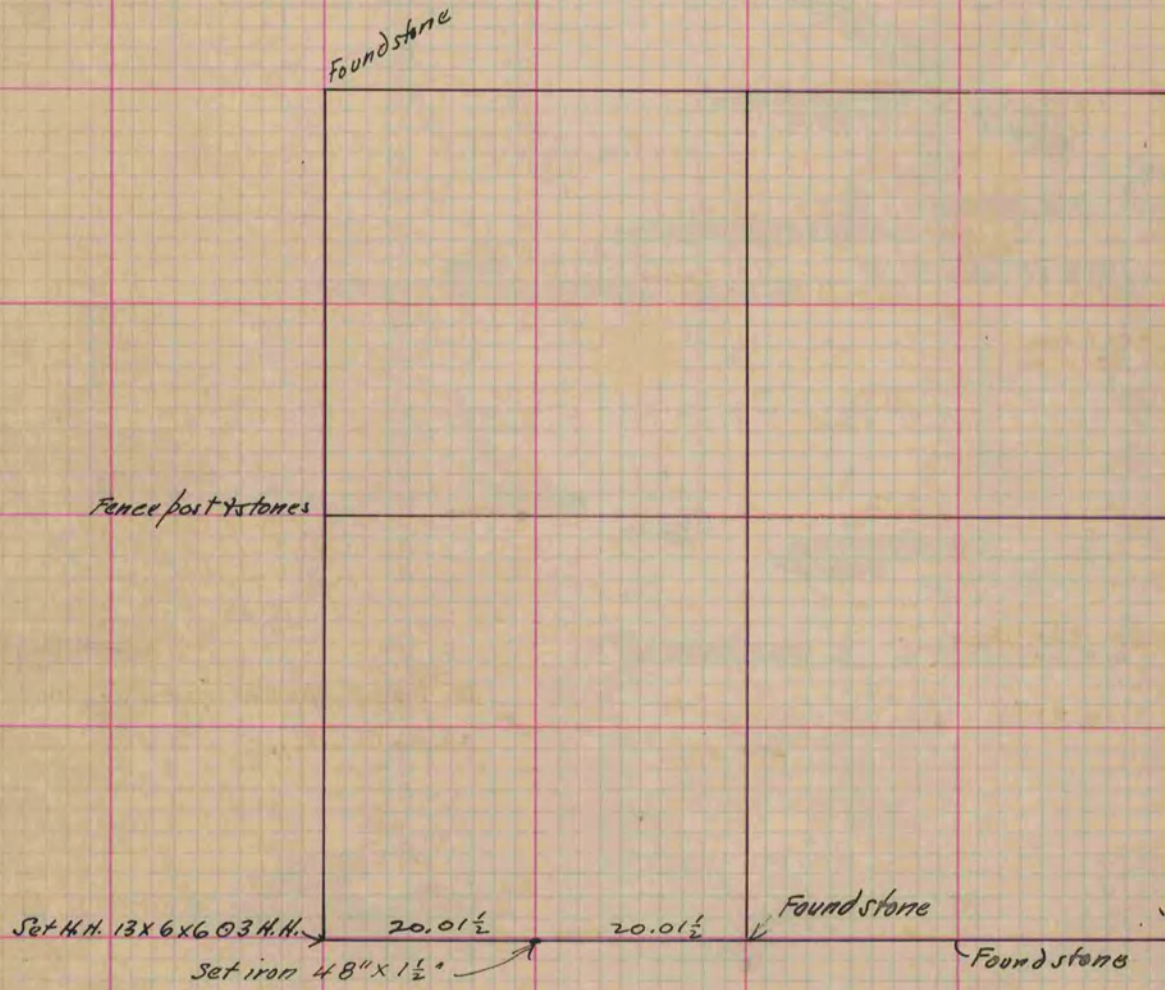

Copied from P. 390 Vol. 2. County Surveyors Record.