

# PLAT AND RECORD

COUNTY BUILDING  
CITY OF JANESVILLE

Of a Survey on Section 3 T 4 N R 10 E of the 4 P. M. in Township

Rock County, Wisconsin, made JANUARY the



I hereby certify that the following is a correct record of said survey as made by me.

*Donald A. Barnes*



**MICROFILMED**

N 1/4 cor Sec 3  
found 1" I.P. from County ties

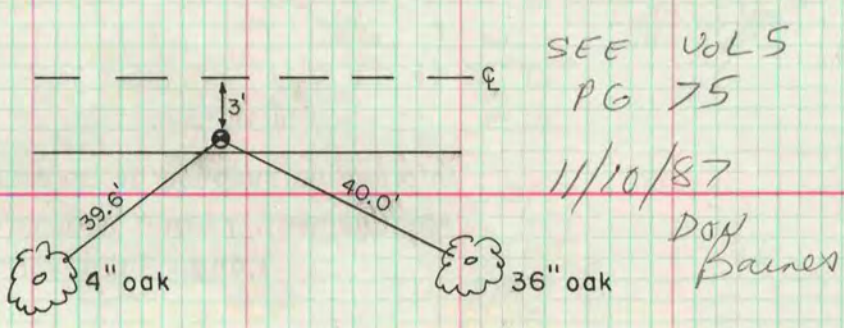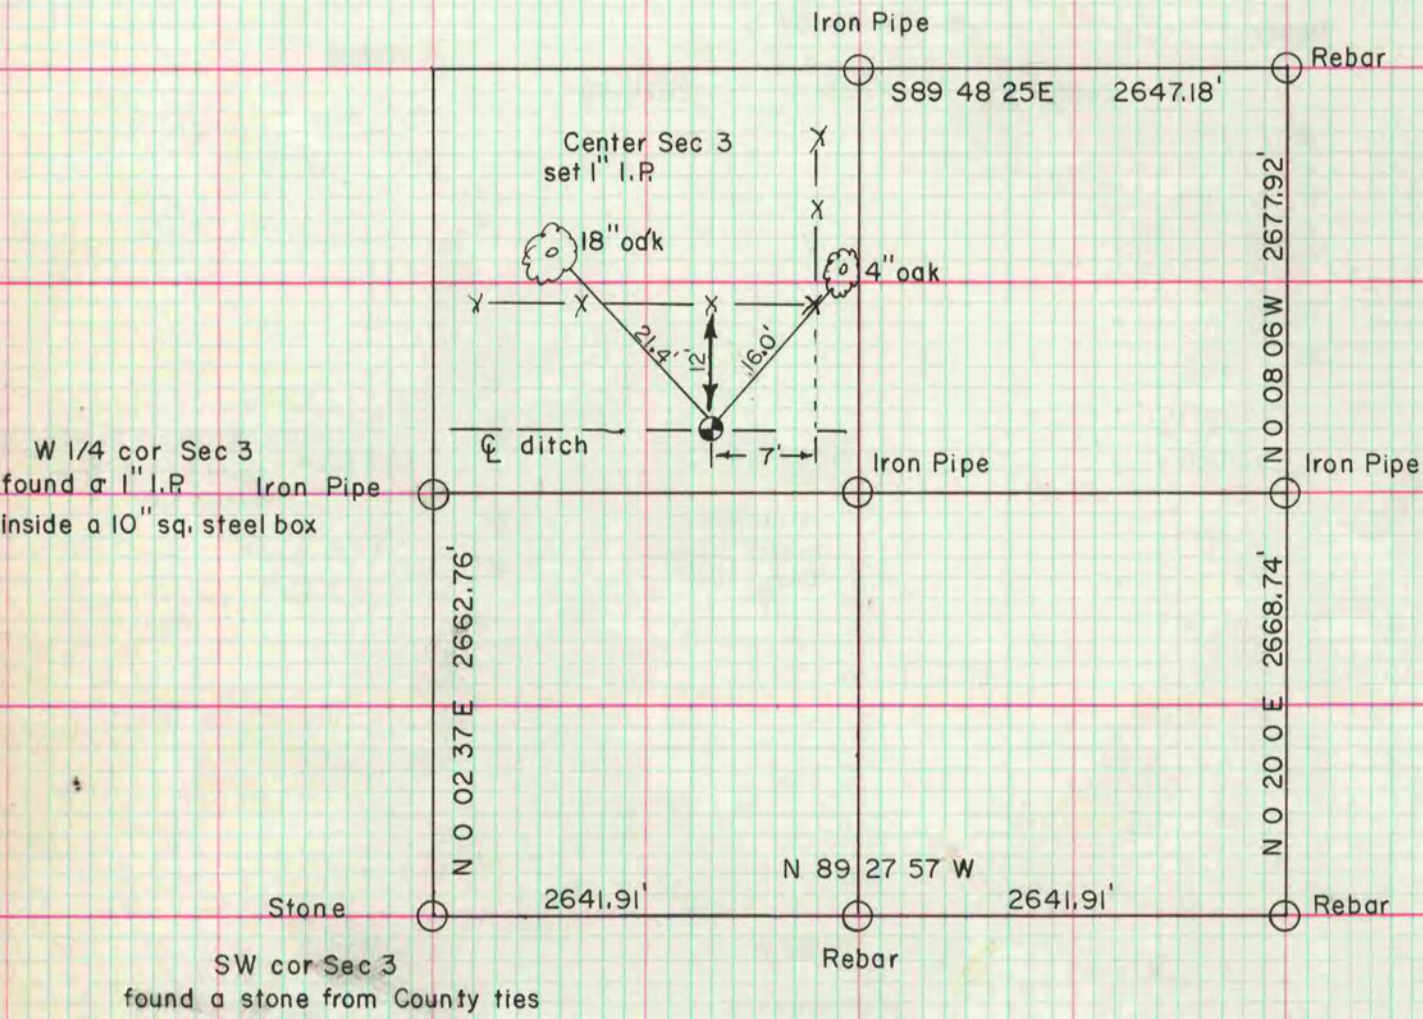

Information supplied by Division of Land Management  
Kermit Wilhelm — Supervisory Land Surveyor