


COUNTY BUILDING
CITY OF JANESVILLE

Of a Survey on Section 12 T 1 R 10 E. of the 4 P. M. in Avon Township

Rock County, Wisconsin, made May the 19+20 1871

I hereby certify that the following is a correct record of said survey as made by me.

(Signed) Edward Ruger
R.H.B. County Surveyor.

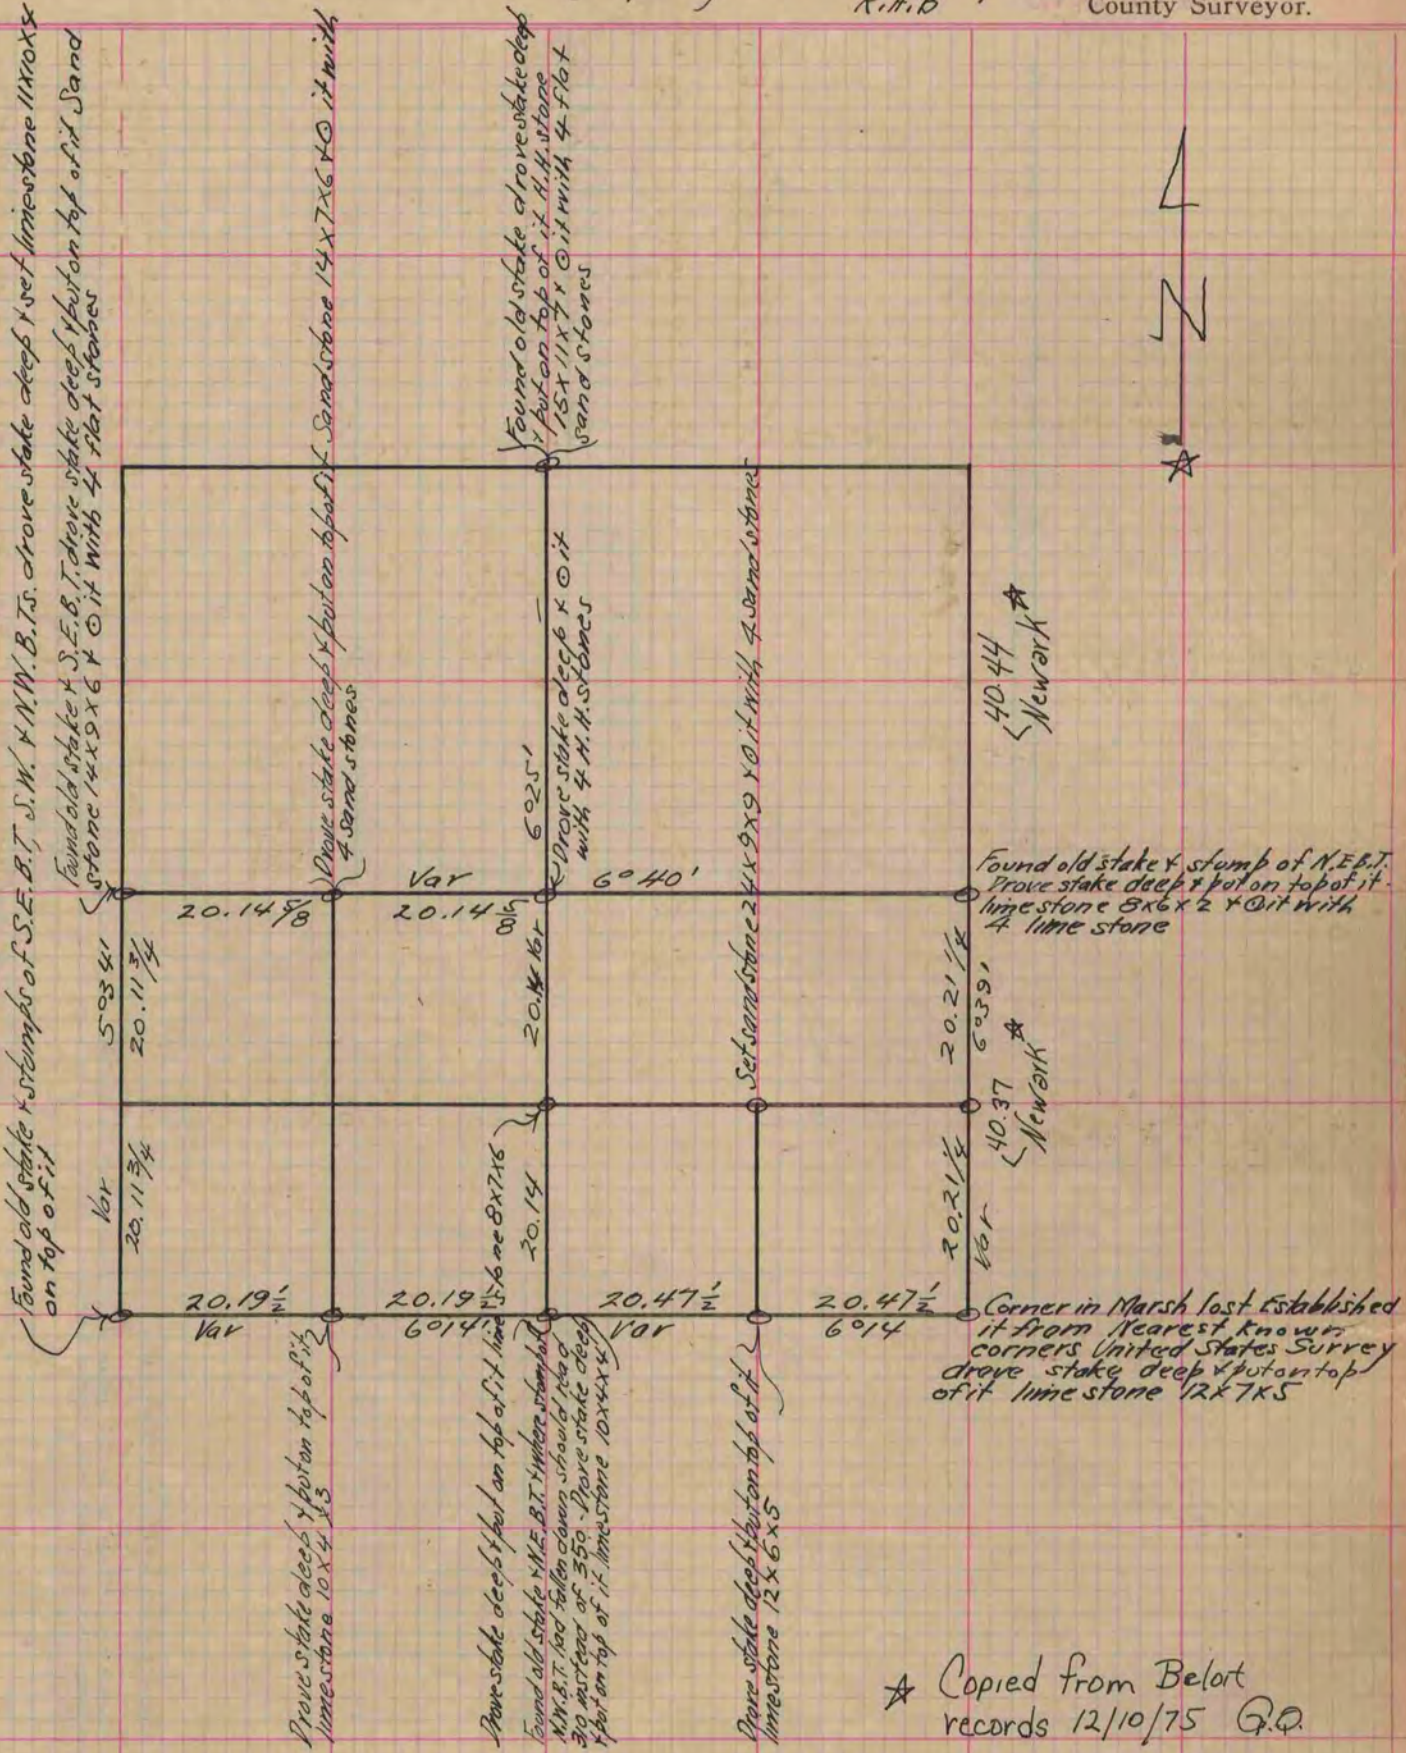

* Copied from Belort records 12/10/75 G.O.

Copied from Page 40 Vol. 2. Original County Surveyors Record