

PLAT AND RECORD

267



COUNTY BUILDING
CITY OF JANESVILLE

VOL. 5

Of a Survey on Section 25 T 4 N R 11 E. of the 4 P. M. in PORTER Township

Rock County, Wisconsin, made APRIL the 7 19 77

I hereby certify that the following is a correct record of said survey as made by me.

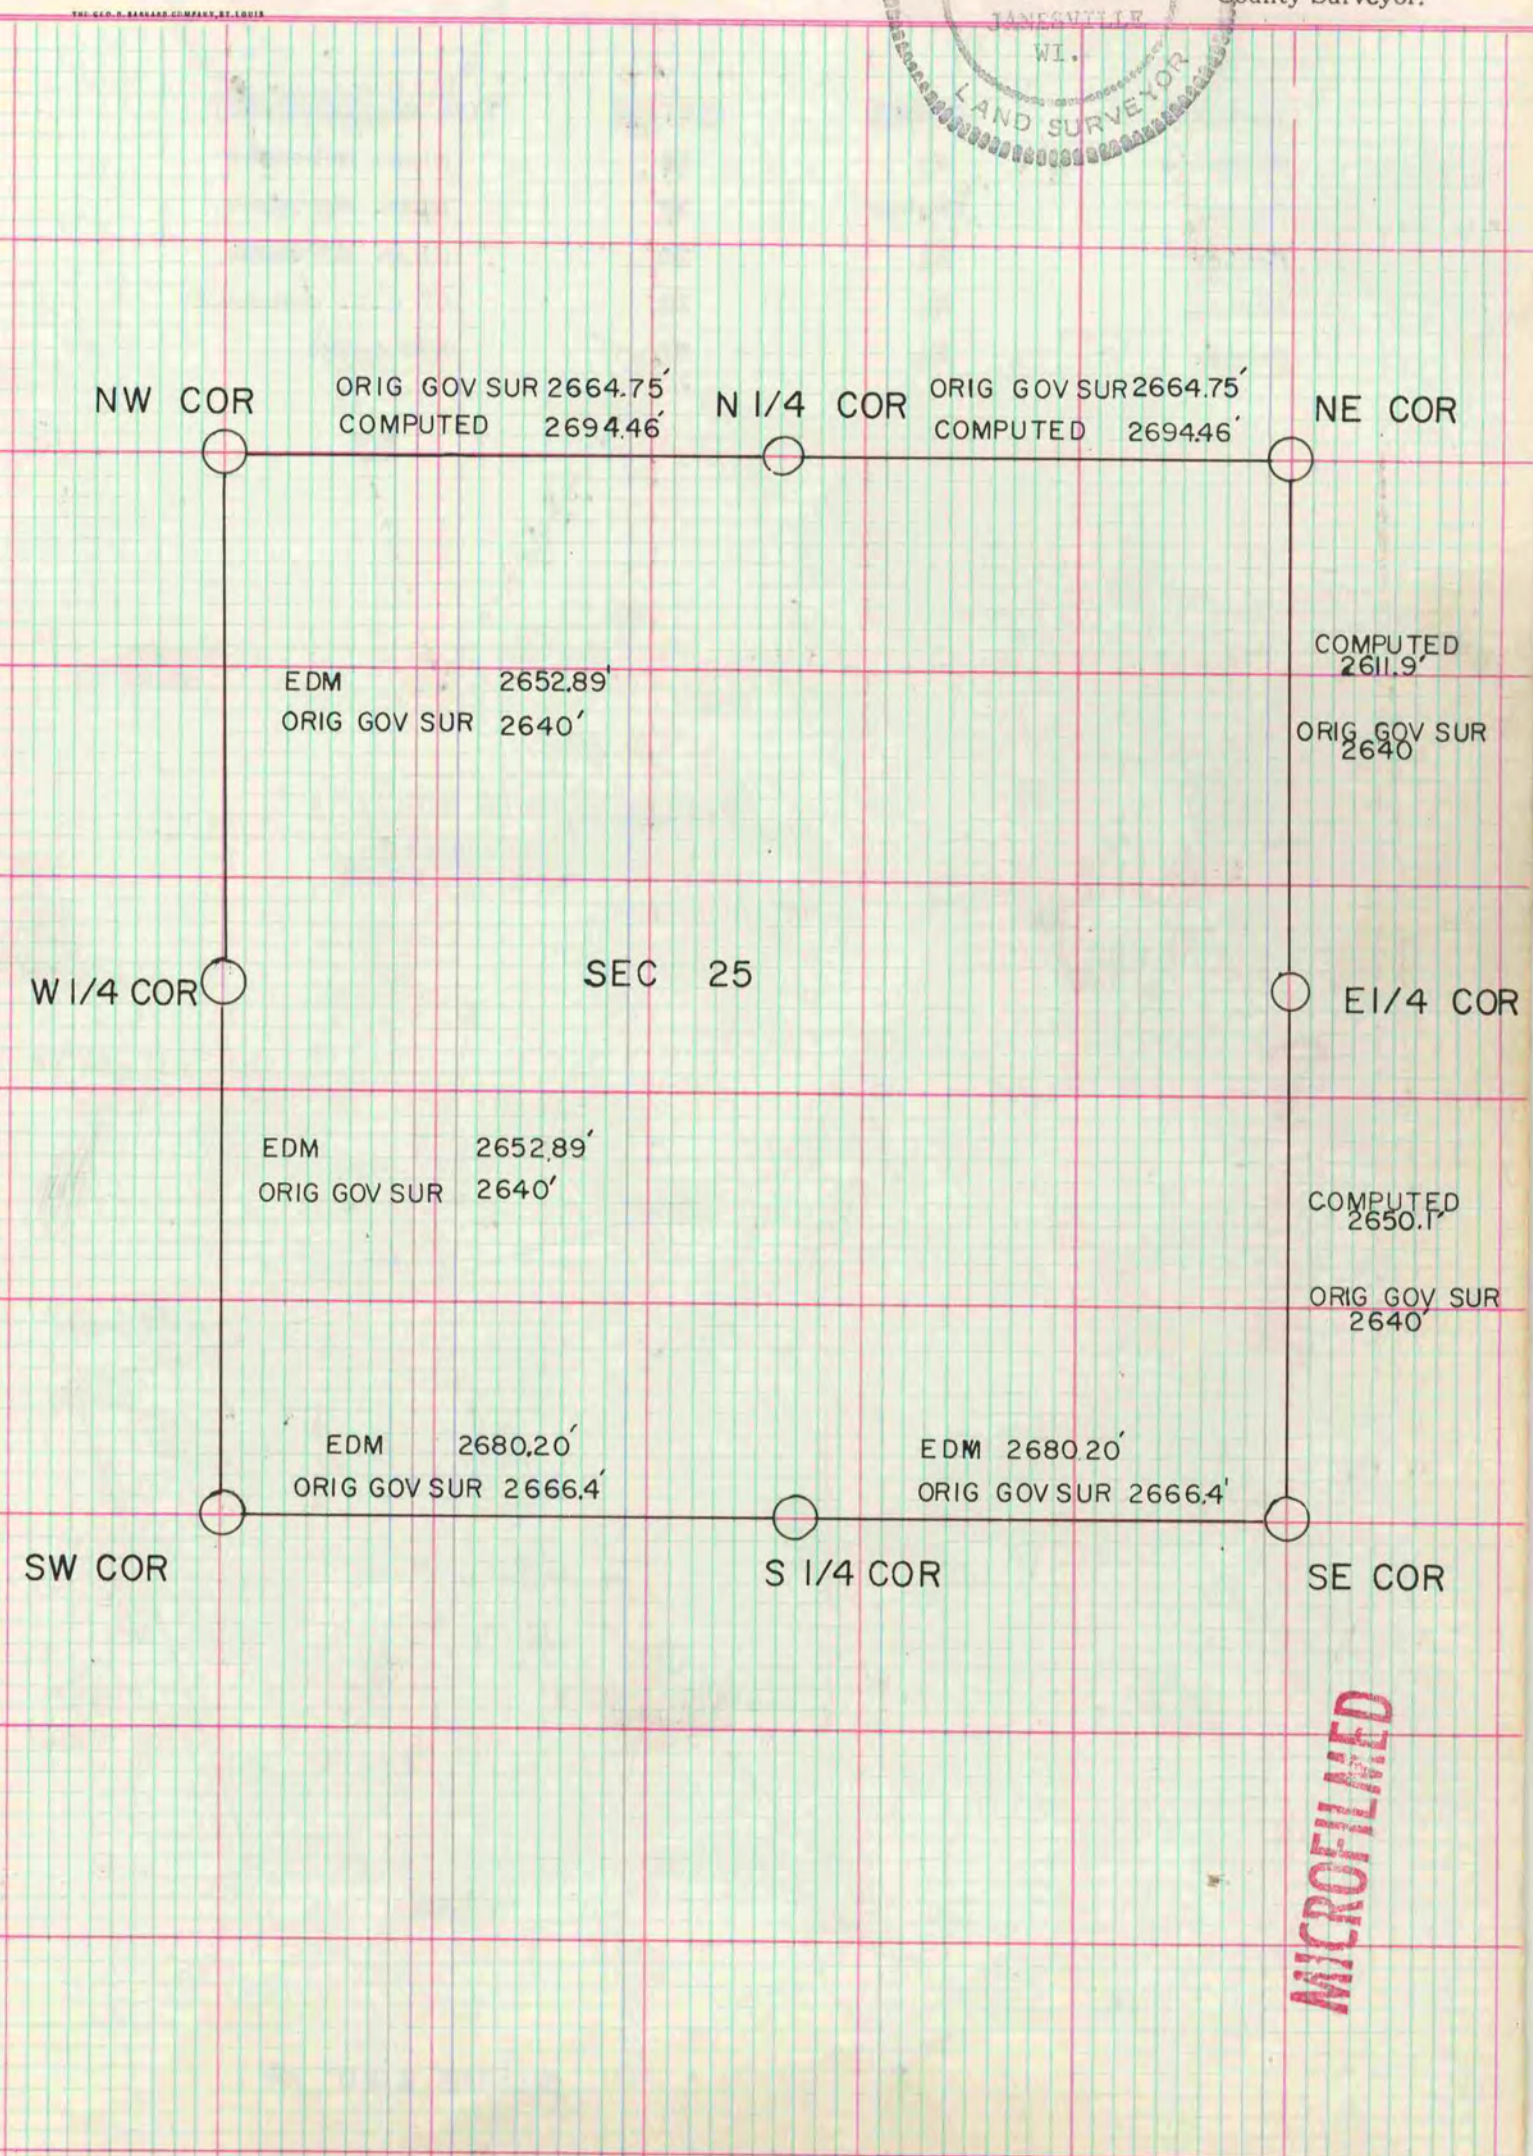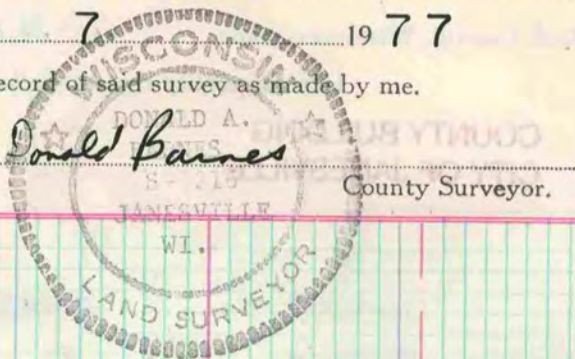

MICROFILMED