

PLAT AND RECORD

277

VOL. 5


Of a Survey on Section 35 T 4 R 11 E. of the 4 P. M. in CENTER PORTER Township
Rock County, Wisconsin, made MAY the 5 1977

I hereby certify that the following is a correct record of said survey as made by me.

COUNTY BUILDING
CITY OF JANESVILLE



SW cor sec 35-4-11 fd pk nail set alum mon.
NE cor sec 3-3-11 fd pk and 1" I.P. set alum mon

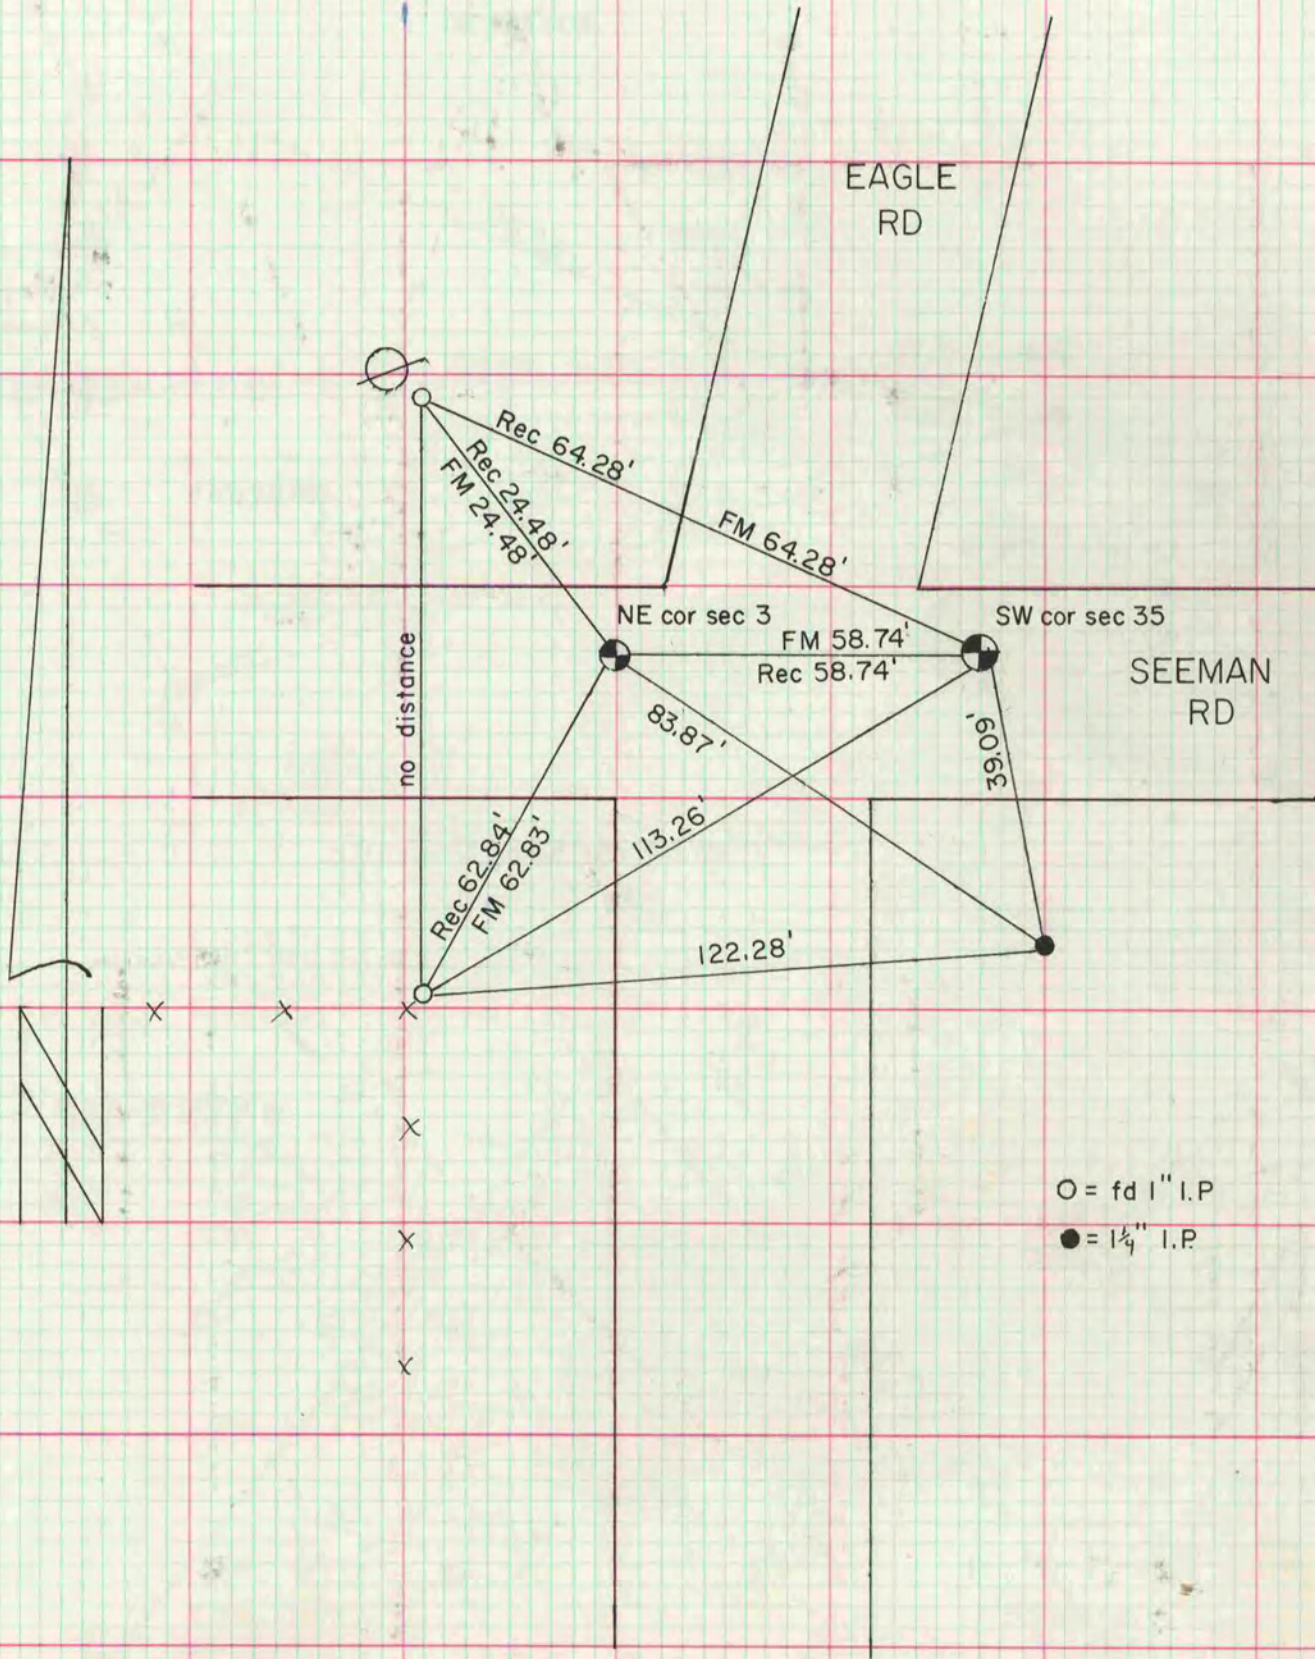

MICROFILMED