

# V-MICROFILMED PLAT AND RECORD


Of a Survey on Section 17 T 3 R 13 E. of the 4 P. M. in Harmony Township

Rock County, Wisconsin, made April 22-1891 & May the 16 1893

I hereby certify that the following is a correct record of said survey as made by me.

COUNTY BUILDING  
CITY OF JANESVILLE

(Signed) O. G. Bleedorn Dep.  
R. H. B. County Surveyor.

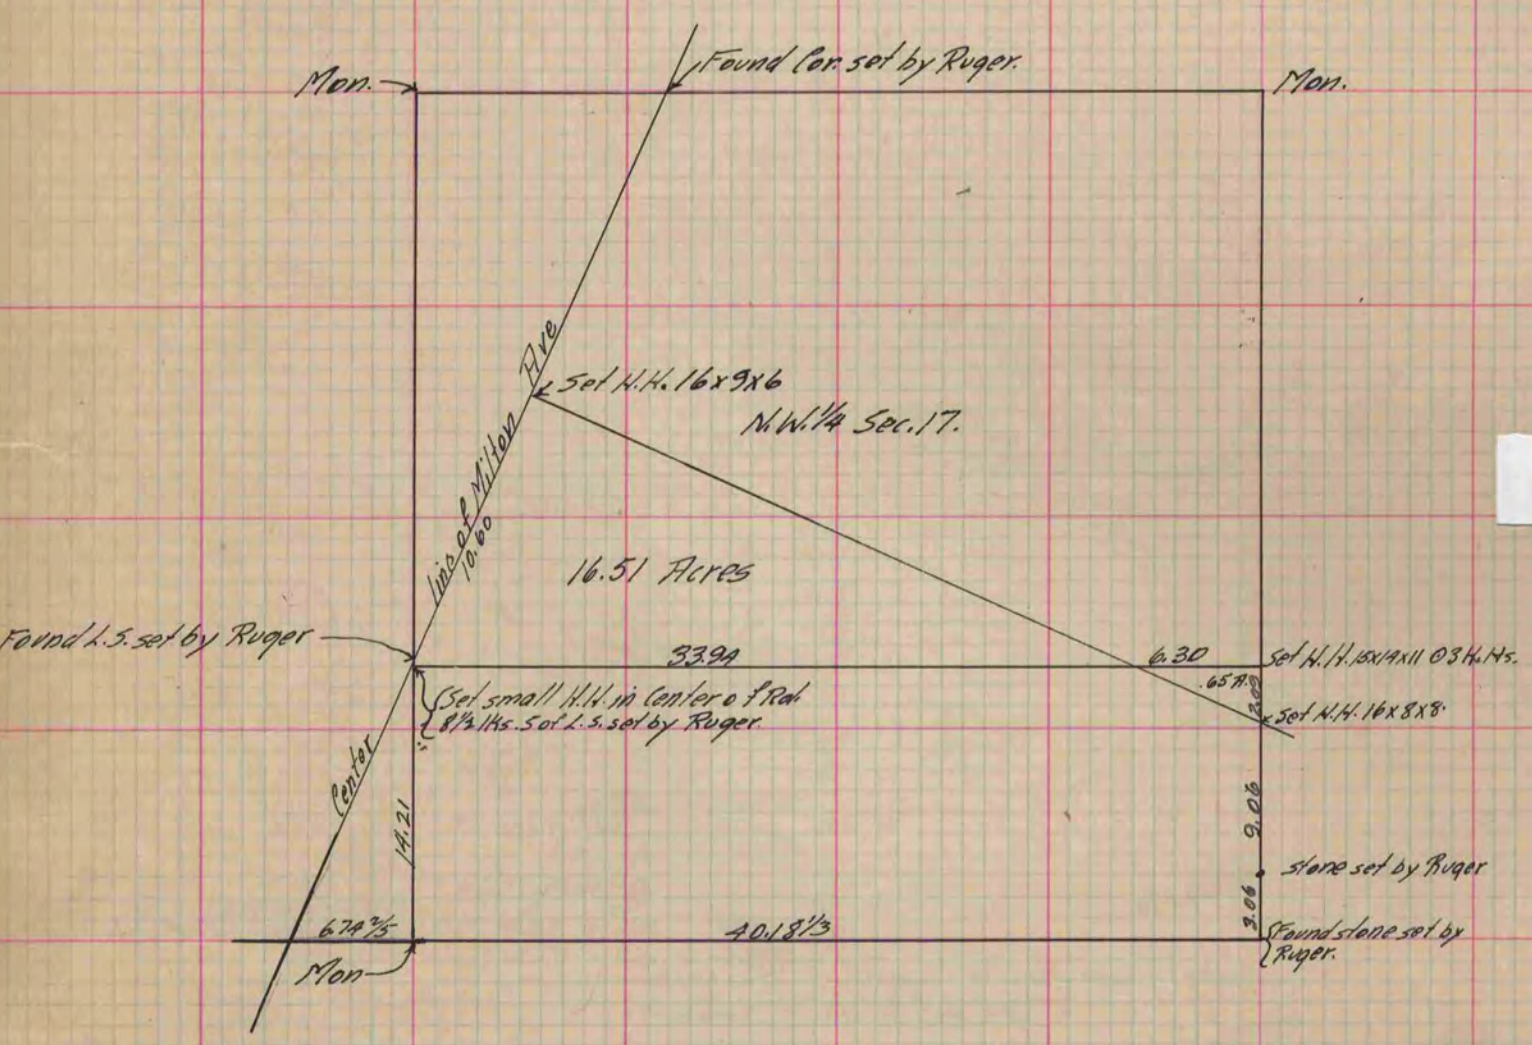

Copied from P. 356 Vol. 2 County Surveyor's Record