

MICROFILMED PLAT AND RECORD


Of a Survey on Section 10 T 2 R 11 E. of the 4 P. M. in Plymouth Township
Rock County, Wisconsin, made April the 14th 1871

I hereby certify that the following is a correct record of said survey as made by me.

COUNTY BUILDING
CITY OF JANESVILLE

(Signed) Edward Ruger
R.H.B.

County Surveyor.

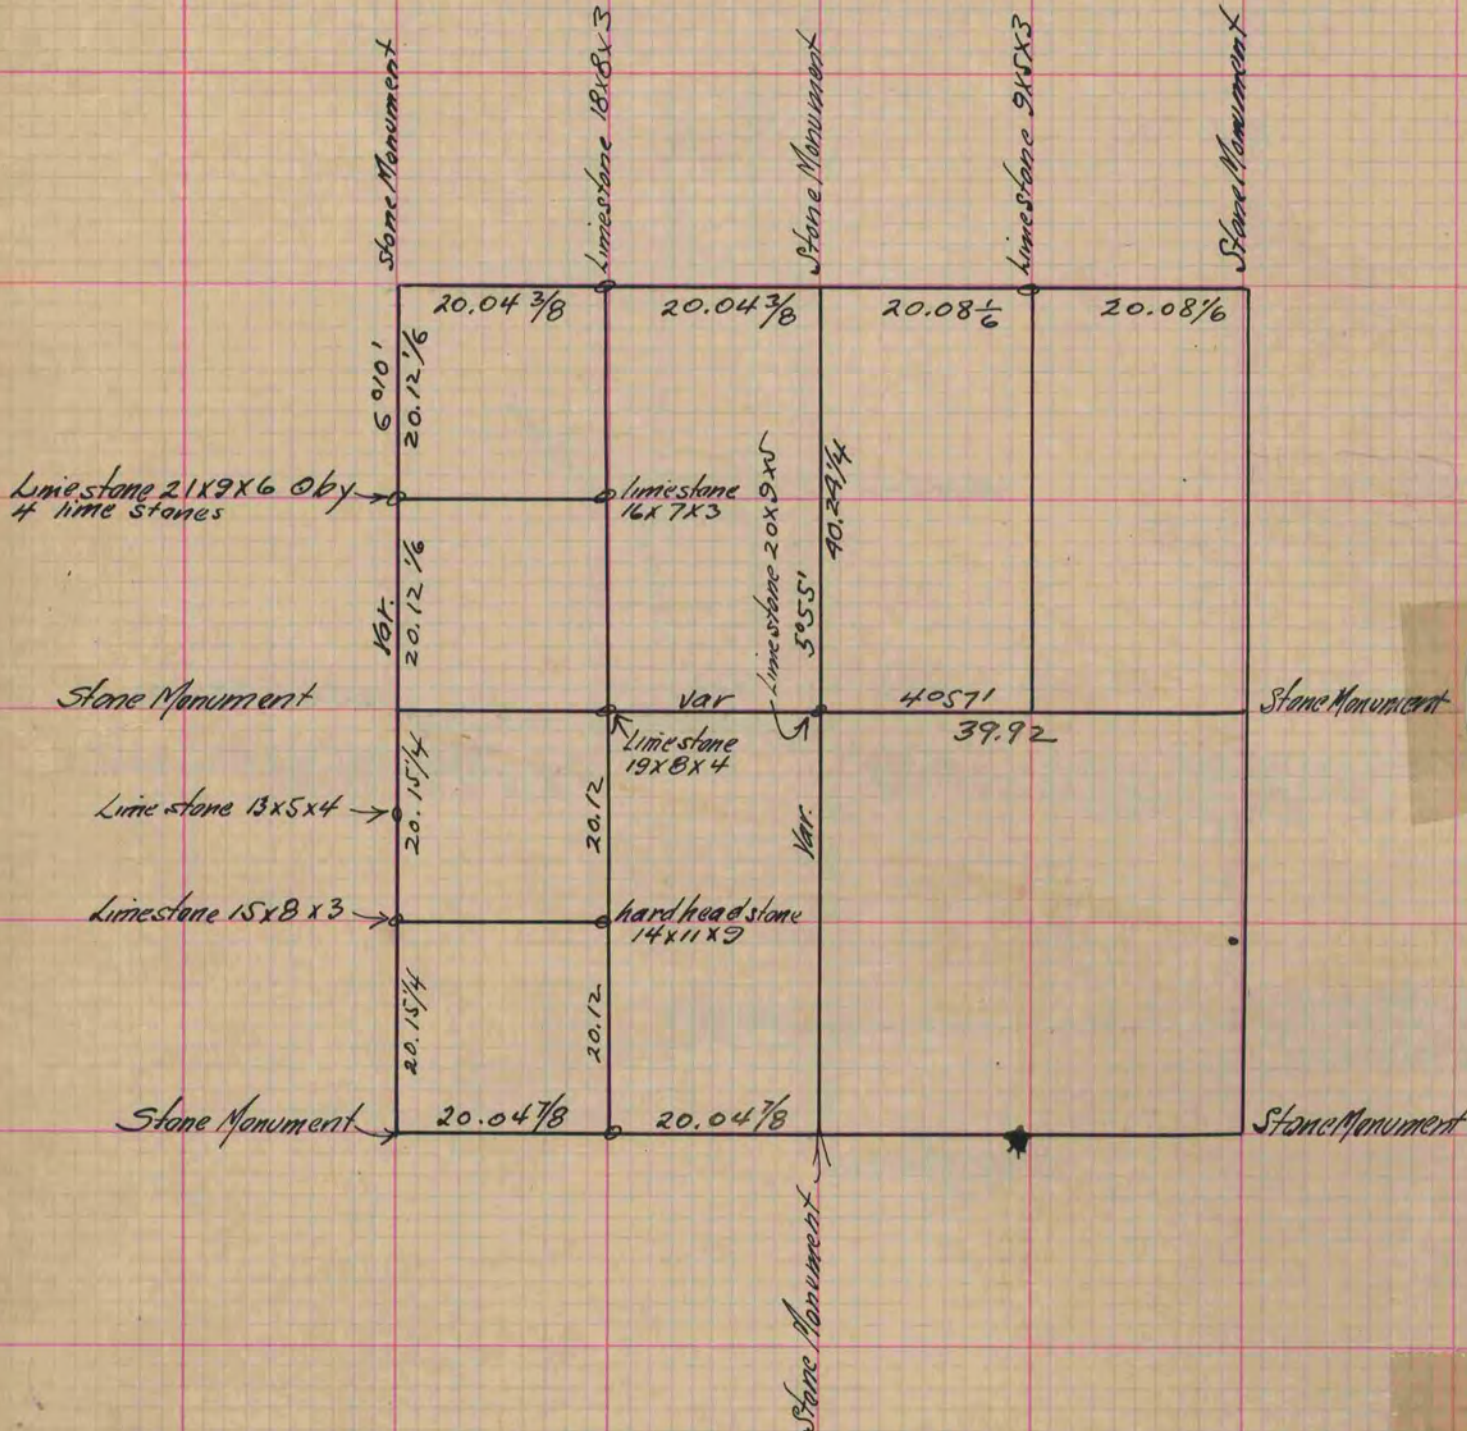

Copied from Page 37 Vol. 2. Original County Surveyors Record