



# PLAT AND RECORD

Of a Survey on Section 1 T. 1 R. 12 E. of the 4 P. M. in BELOIT Township  
Rock County, Wisconsin, made JAN. the 26 1981

COUNTY BUILDING CITY OF JANESVILLE hereby certify that the following is a correct record of said survey as made by me.



SW COR SEC 1  
TIES MADE TO LIMESTONE  
11-4-80, CTH, EJR

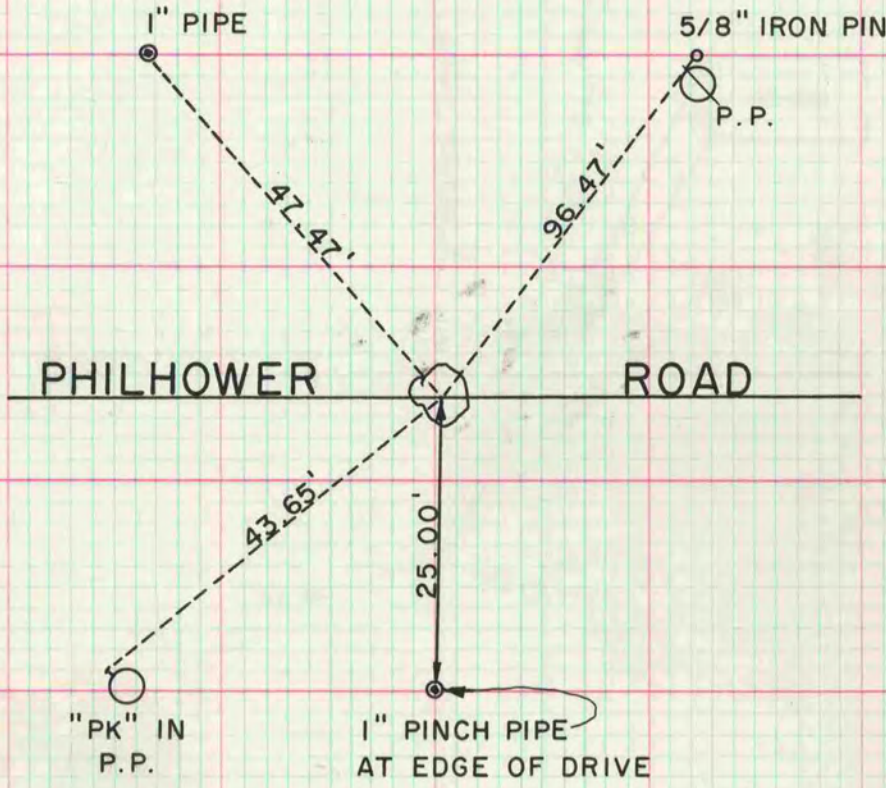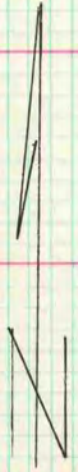

MICROFILMED