

**MICROFILMED**

# PLAT AND RECORD

Of a Survey on Sections 25 & 36 T 1 R 12 E. of the 4 P. M. in Beloit Township

Rock County, Wisconsin, made June the 1882

I hereby certify that the following is a correct record of said survey as made by me.

COUNTY BUILDING  
CITY OF JANESVILLE

(Signed) Edward Ruger  
R. H. B


County Surveyor.

Found stake 0 by 3 limestones  
one of them burnt, also found stump  
of N.W. B.T.

Found stumps of both B.T.s. & remains  
of old stake. Drove new stake in place  
of old & oil by 6 cobble stones.

Drove 3/4" iron rod also drove 3/8" rods  
15 lbs. E. 34°. Drove stake. No. rod at  
Cor. Took B.T. W.D. 7 N. 5 1/2' W. 259  
" " 8 N. 19° W. 29 1/2

Found stake man. & N.E. B.T. in hole stump  
of S.E. B.T. had decayed. Took new B.T.s.  
Hickory 5 s. 39° E 32  
Br. O. 7 s. 46° W. 18 1/2  
Hickory 6 s. 64 1/2 W. 49

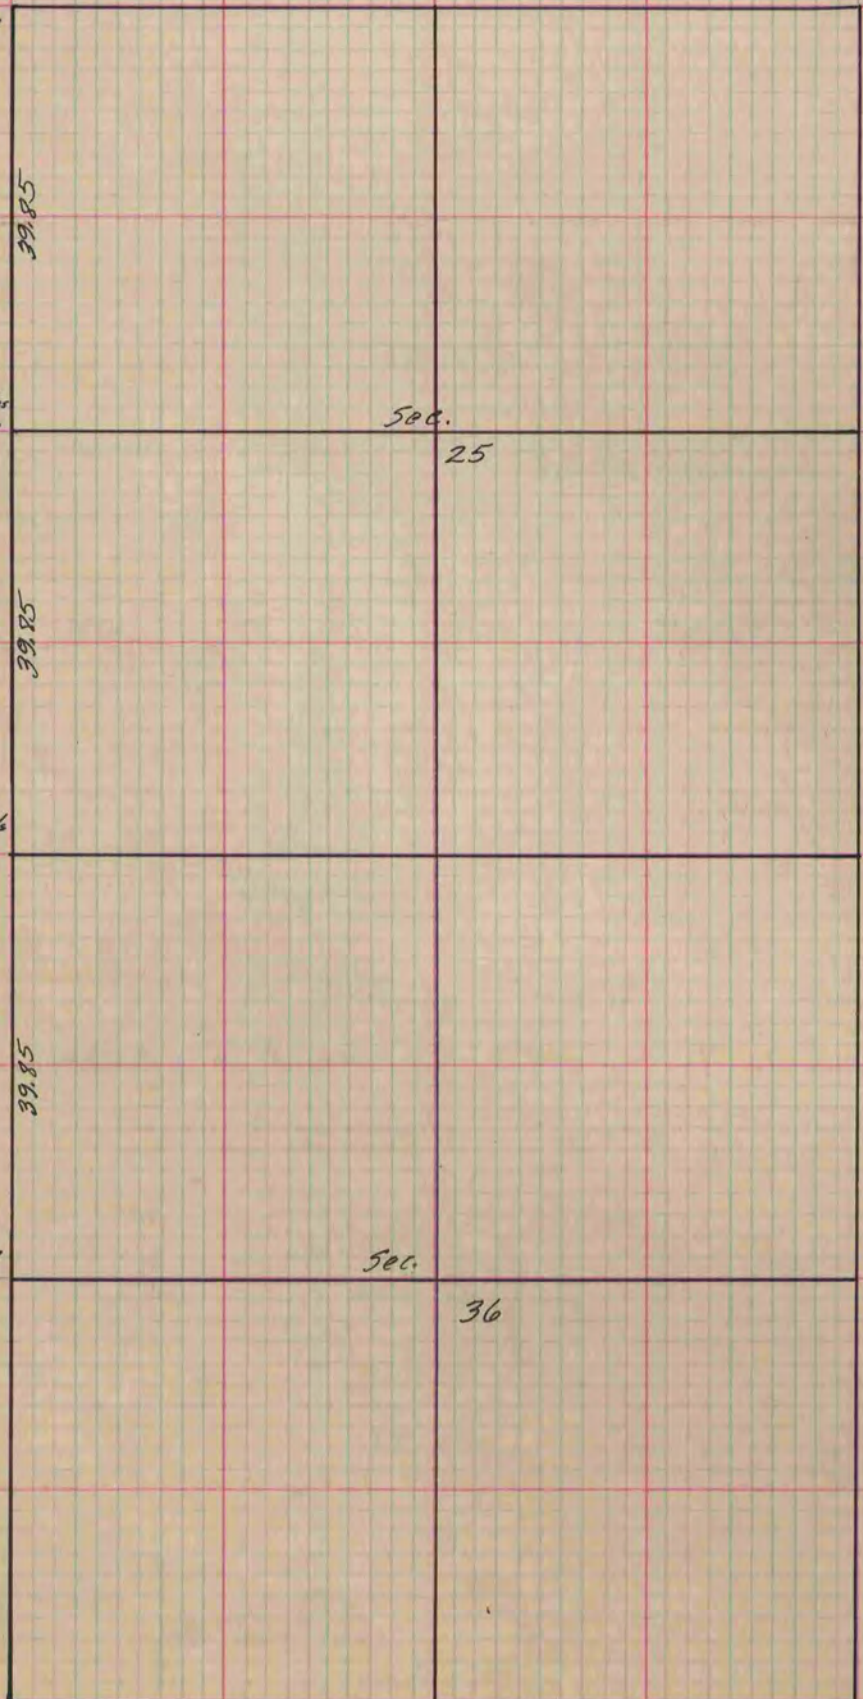

Copied from P. 329 Vol. 2 County Surveyors Record.