

MICROFILMED
COUNTY BUILDING
CITY OF JANESVILLE

PLAT AND RECORD

Of a Survey on Section 25 T 3 R 14 E. of the 4 P. M. in Johnstown Township


Rock County, Wisconsin, made Oct. the 24th. 1887

I hereby certify that the following is a correct record of said survey as made by me.

COUNTY BUILDING
CITY OF JANESVILLE

(Signed) Edward Ruger

County Surveyor.

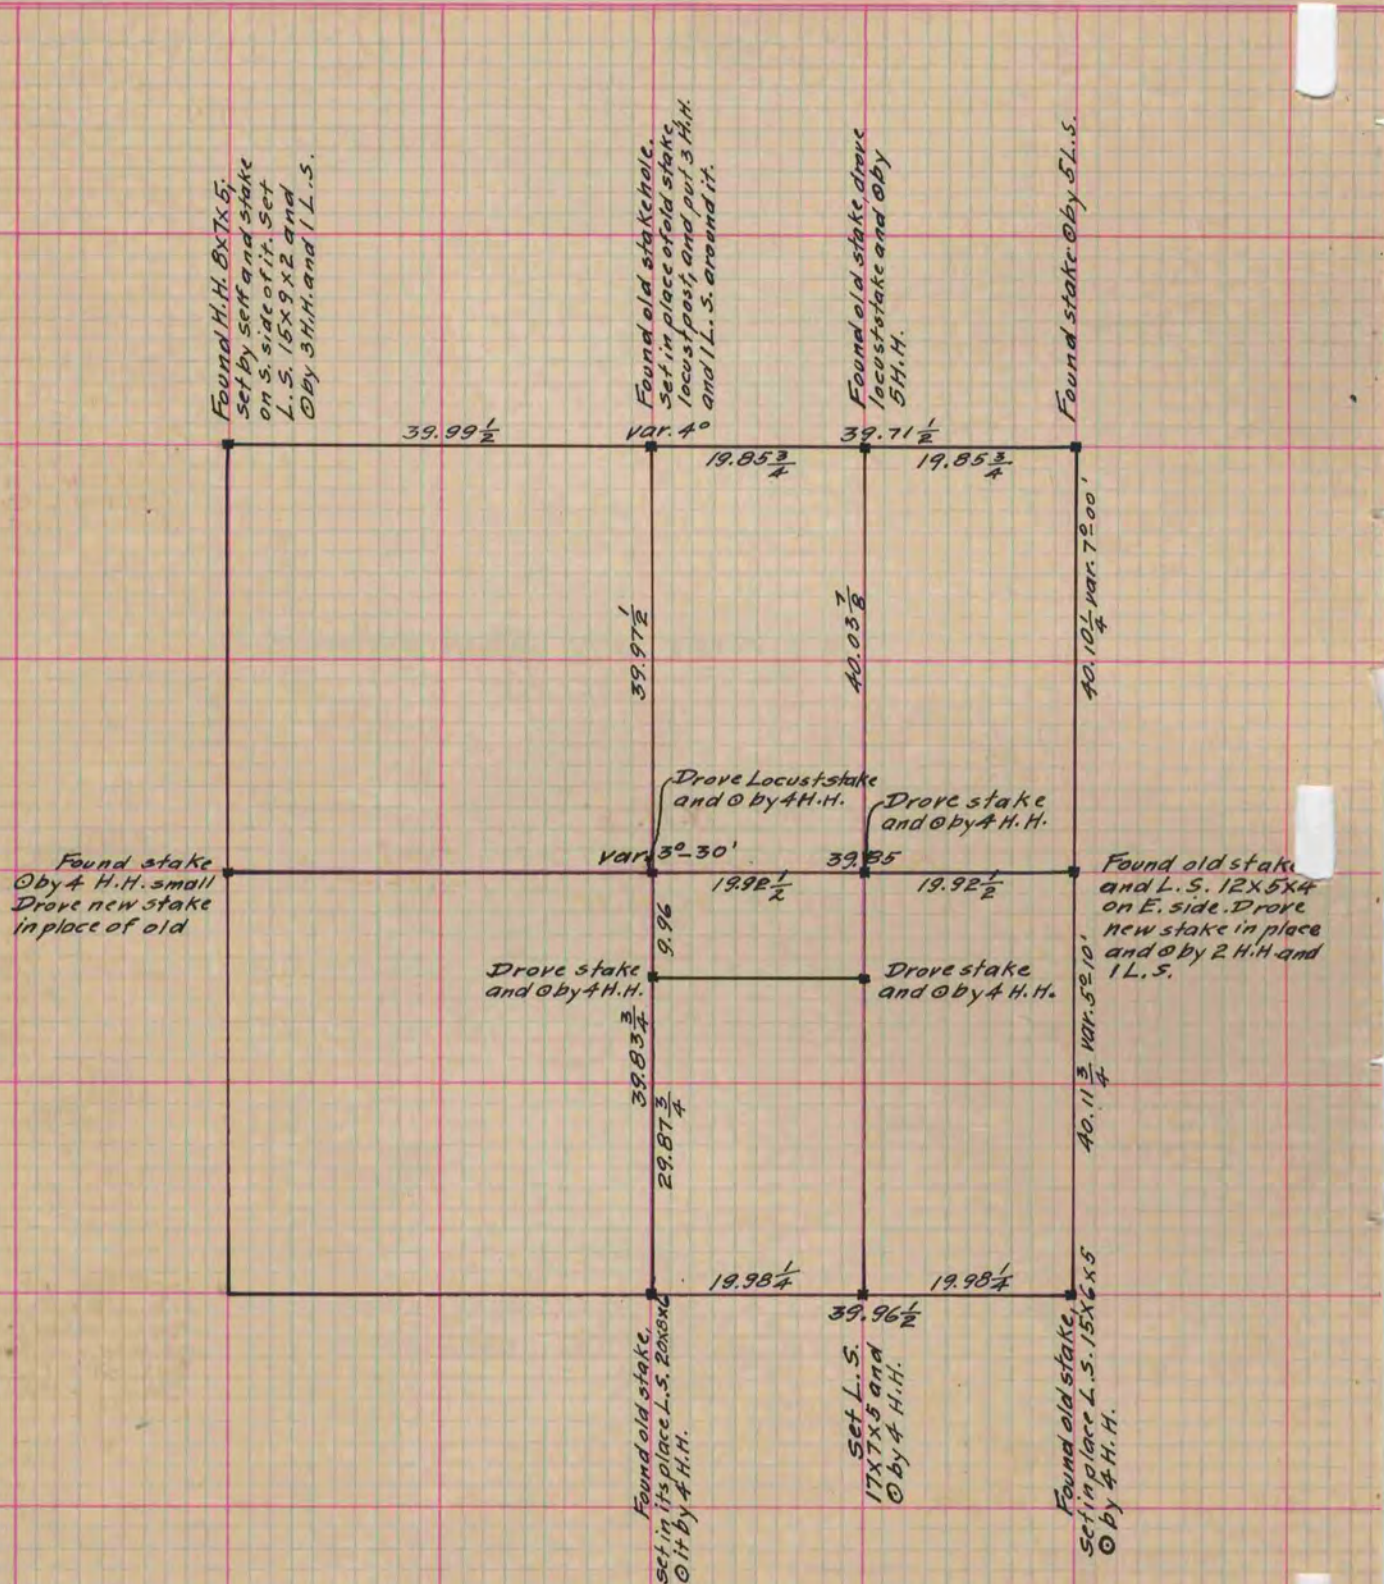

Copied from page 336 Vol. 2 County Surveyors Record