

V-2 MICROFILMED

PLAT AND RECORD

COUNTY BUILDING
CITY OF JANESVILLE


Of a Survey on Section 10 T 1 R 10 E. of the 4 P. M. in Arion Township

Rock County, Wisconsin, made June the 25, 26 & 27 1874

I hereby certify that the following is a correct record of said survey as made by me.

(Signed) Edward Ruger
R. H. B.

County Surveyor.

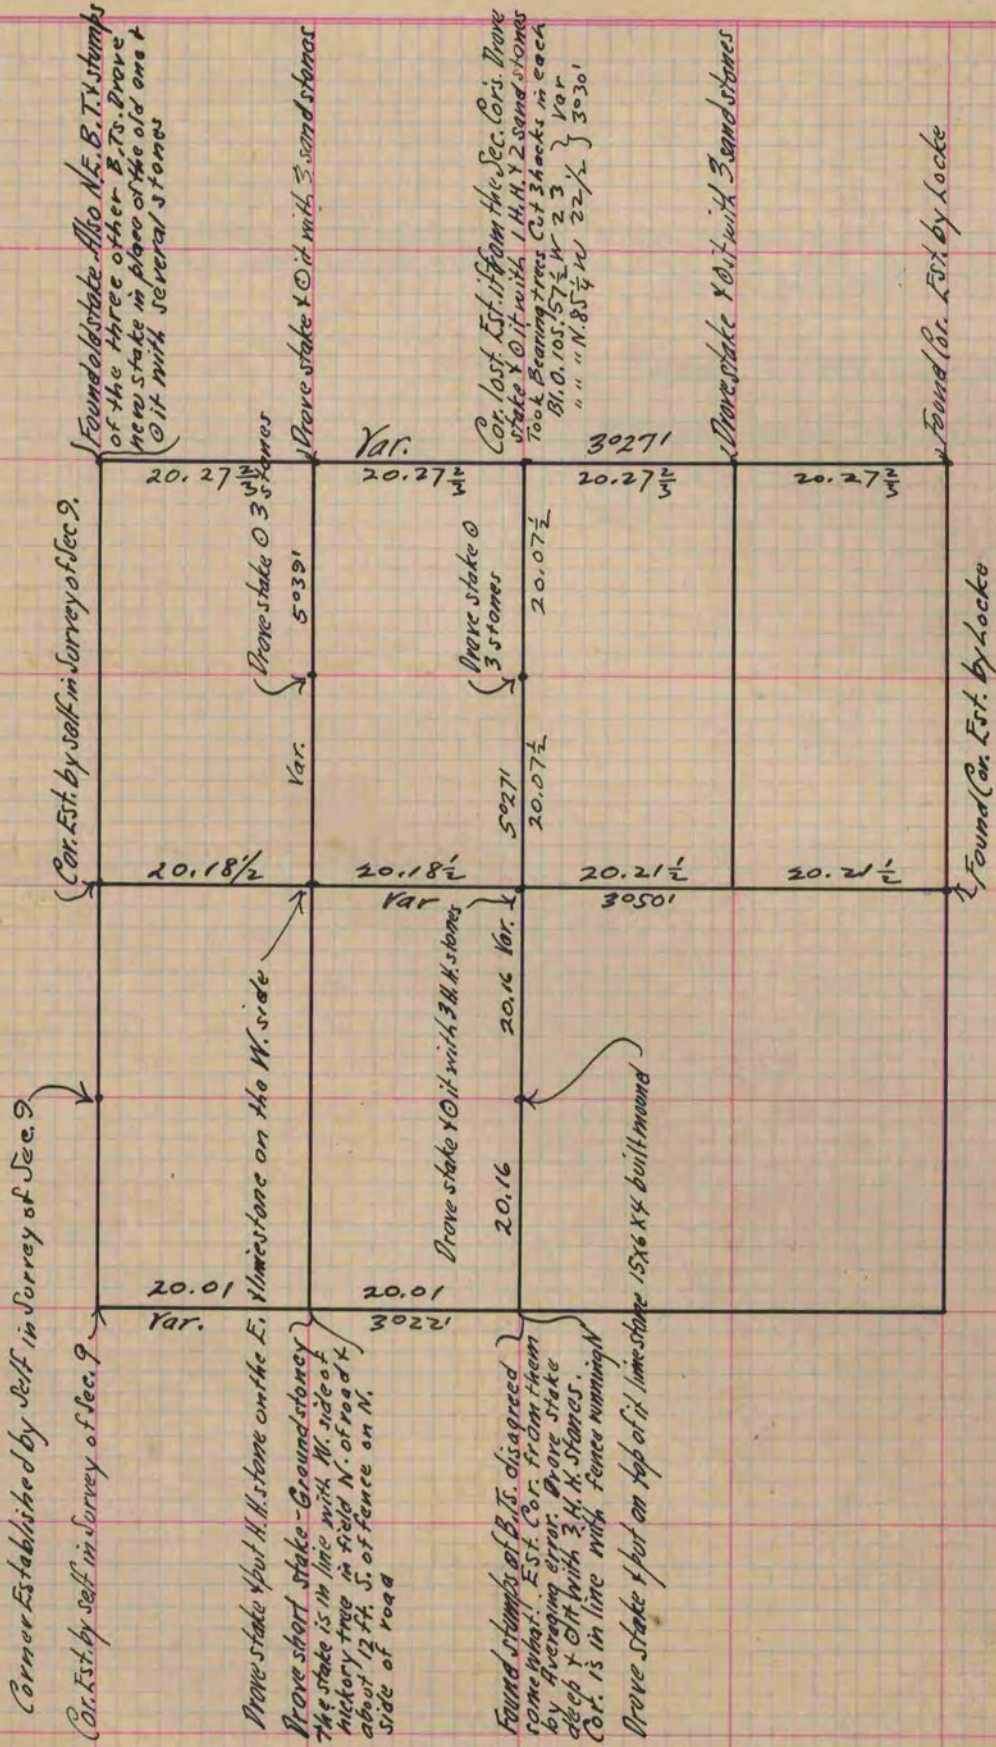

Copied From Page 103 Vol. 2 Original County Surveyors Record