

PLAT AND RECORD

COUNTY BUILDING
CITY OF JANESVILLE


Of a Survey on Section 5, 6 T 2 R 10 E. of the 4 P. M. in SPRING VALLEY Township

Rock County, Wisconsin, made SEPTEMBER the 25 th. 1961

I hereby certify that the following is a correct record of said survey as made by me.

R. B. Battman

County Surveyor.

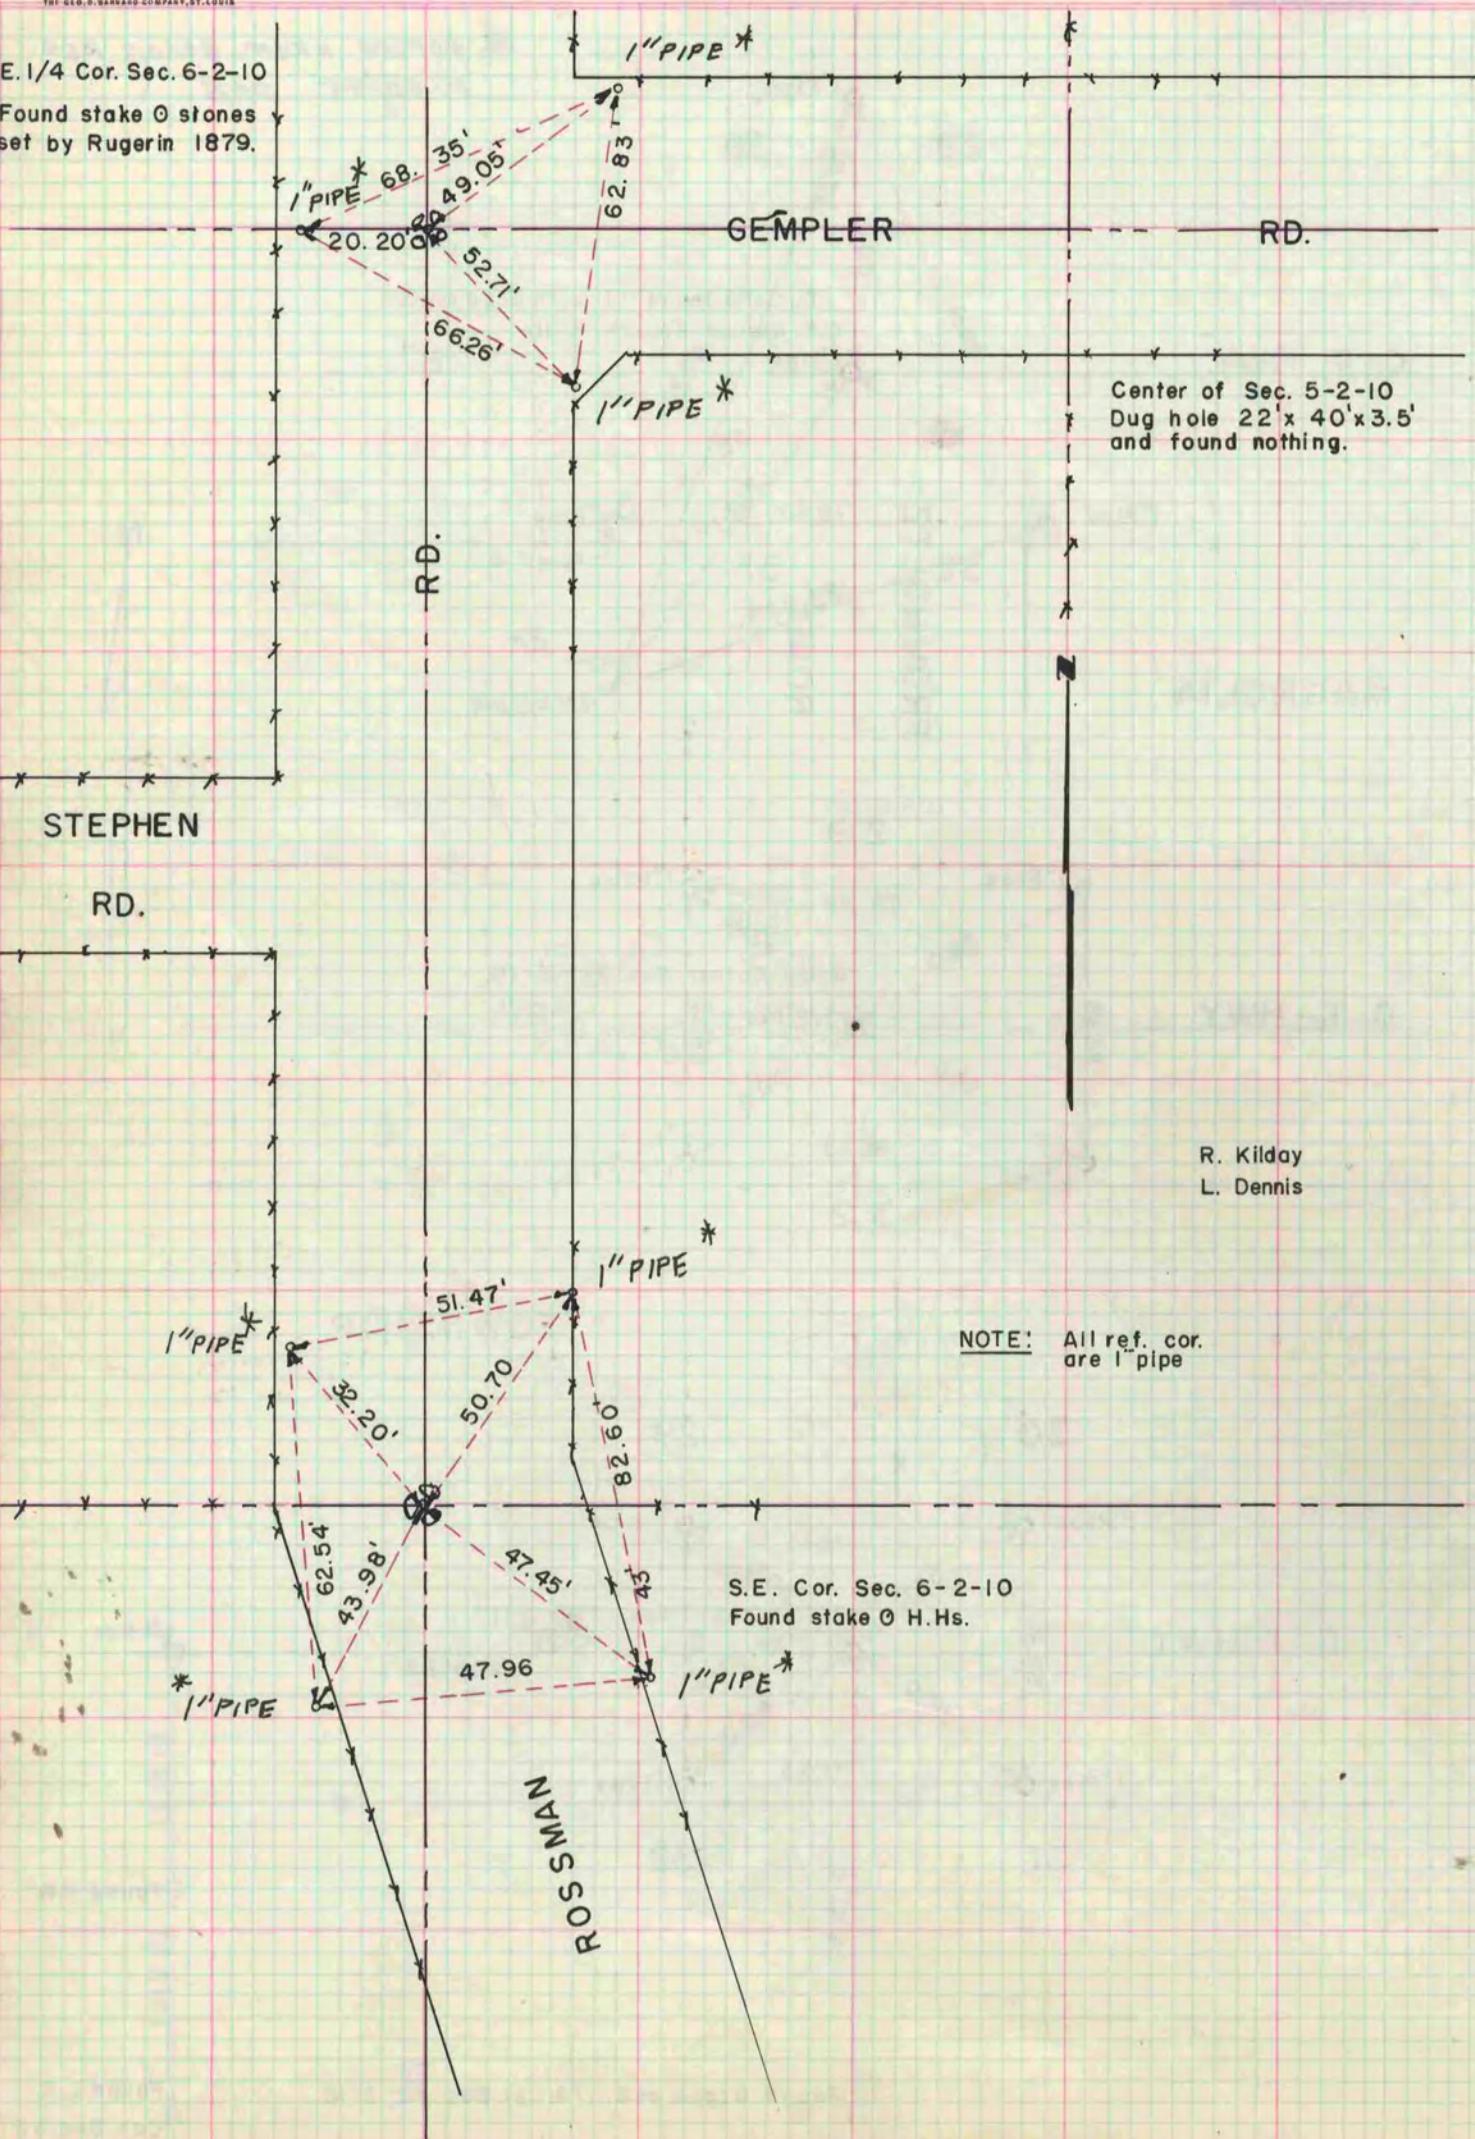

R. Kilday
L. Dennis