


PLAT AND RECORD

CIVIL COUNTY BUILDING
CITY OF JANESVILLE

Of a Survey on Section 6 T 4 N R 10 E. of the 4 P. M. in UNION Township
Rock County, Wisconsin, made March the 19 1976

I hereby certify that the following is a correct record of said survey as made by me.

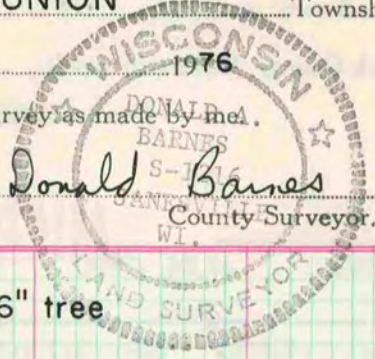

MICROFILMED

THE KEO P. BARNARD COMPANY, ST. LOUIS

