

# PLAT AND RECORD

125  
v-4

COUNTY BUILDING  
CITY OF JANESVILLE

PAGE 122  
BELOIT REC.  
12/8/75 DAB  
Township


Of a Survey on Section 21 T. 2 N. R. 12 E. of the 4 P. M. in ROCK

Rock County, Wisconsin, made FEBRUARY the 2nd 1962

I hereby certify that the following is a correct record of said survey as made by me.

**MICROFILMED**

*R. B. Hoffman*  
County Surveyor.

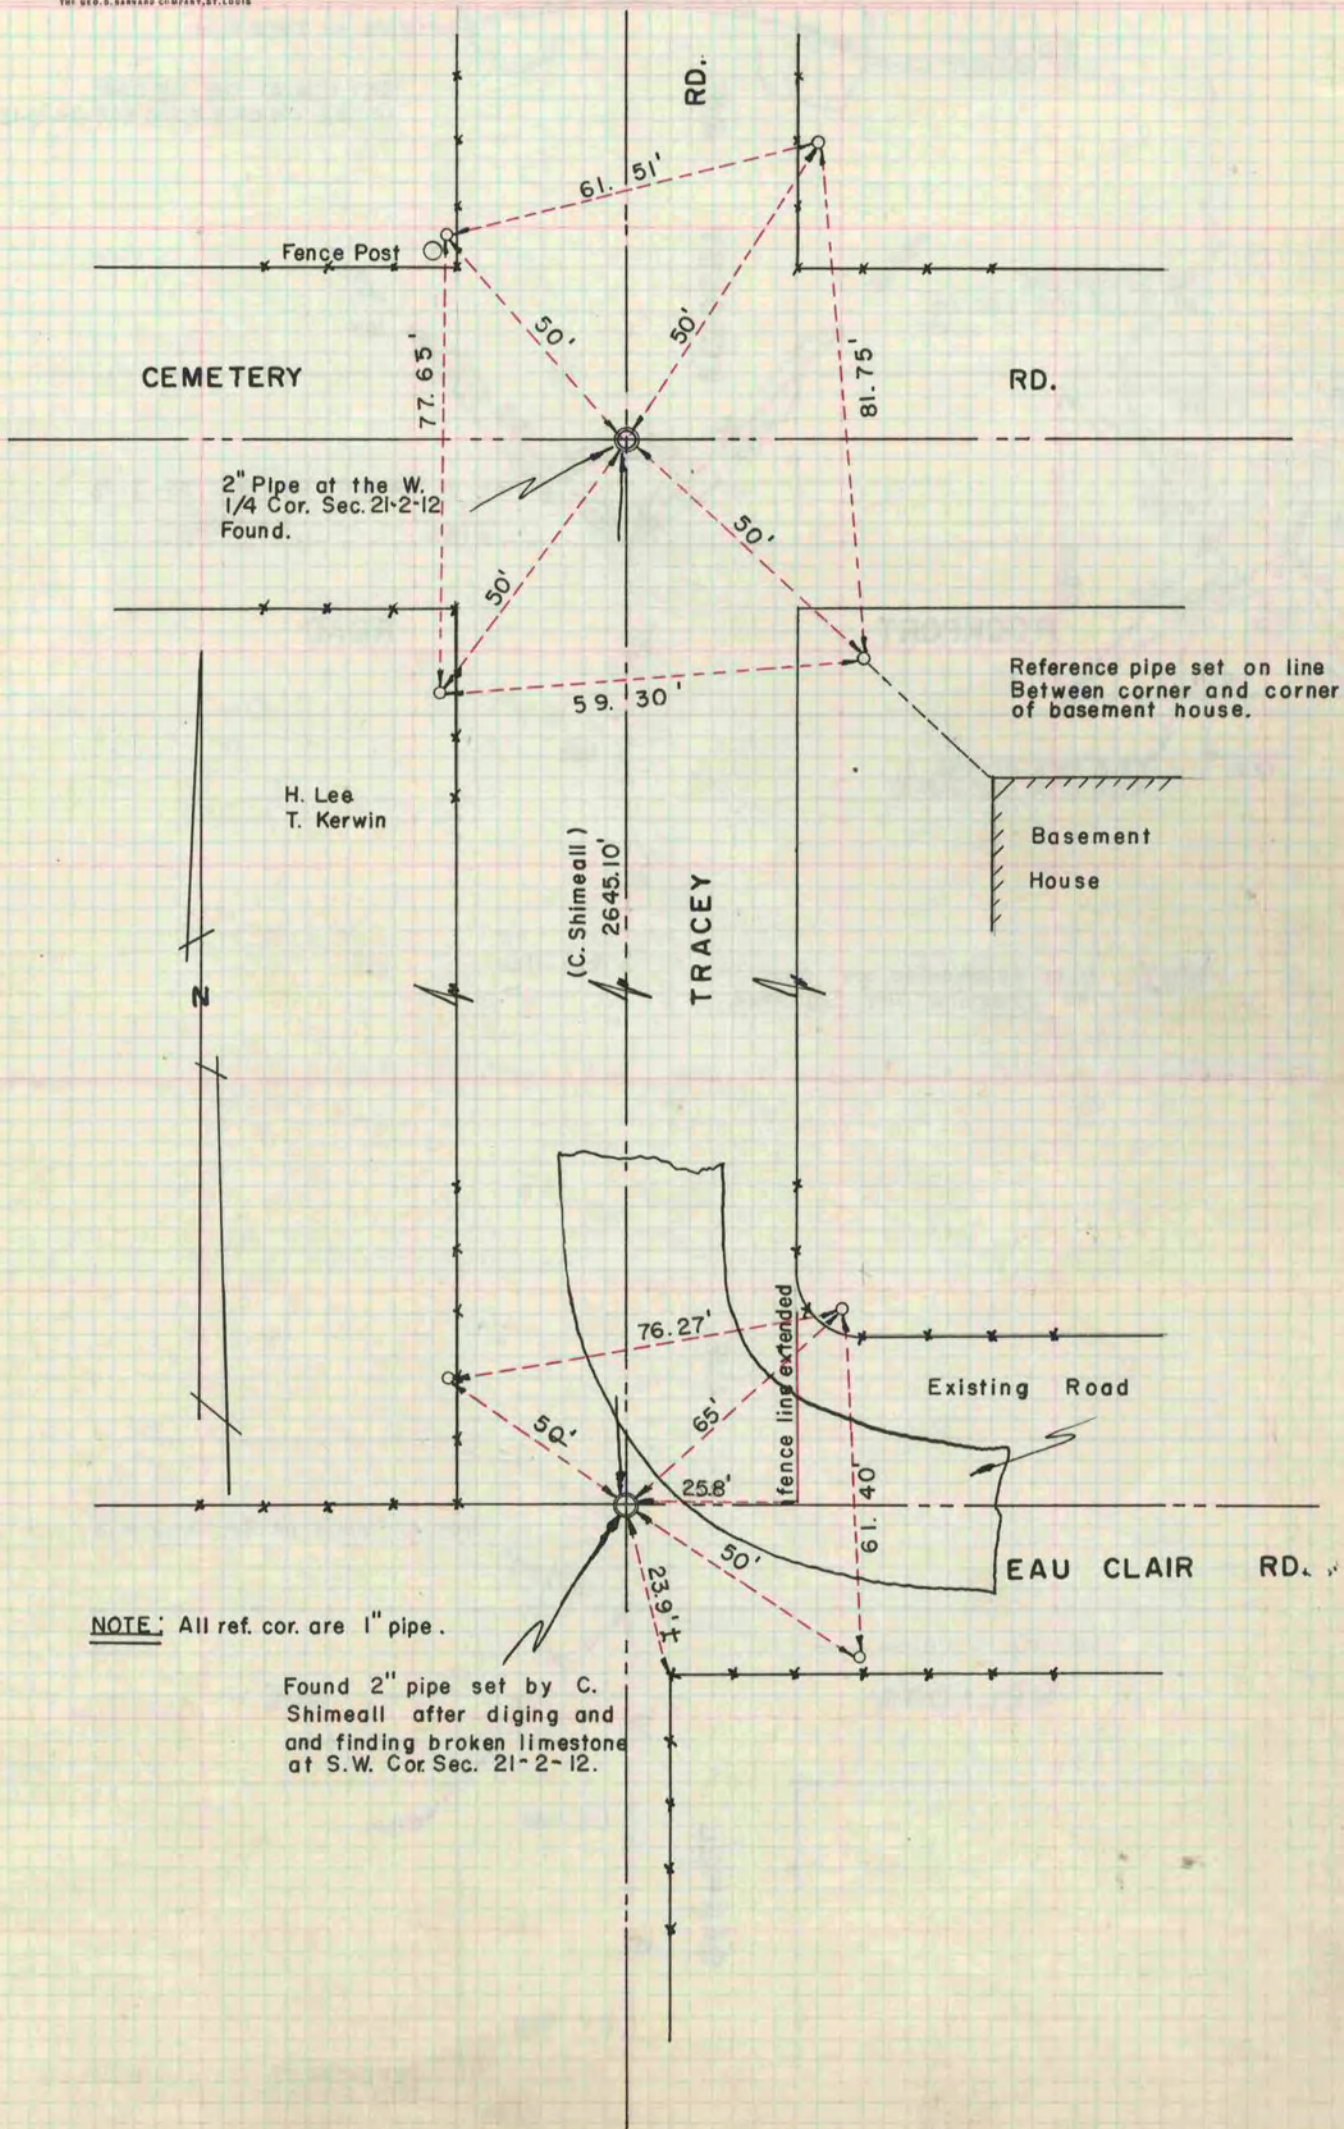

NOTE: All ref. cor. are 1" pipe.

Found 2" pipe set by C. Shimeall after digging and finding broken limestone at S.W. Cor. Sec. 21-2-12.