

Of a Survey on Section **32** T **2N** R **14** E. of the 4 P. M. in **BRADFORD** Township


Rock County, Wisconsin, made **JUNE** the **26** 1969

I hereby certify that the following is a correct record of said survey as made by me.

**MICROFILMED**

*Robert B. Egan Jr.*

County Surveyor.

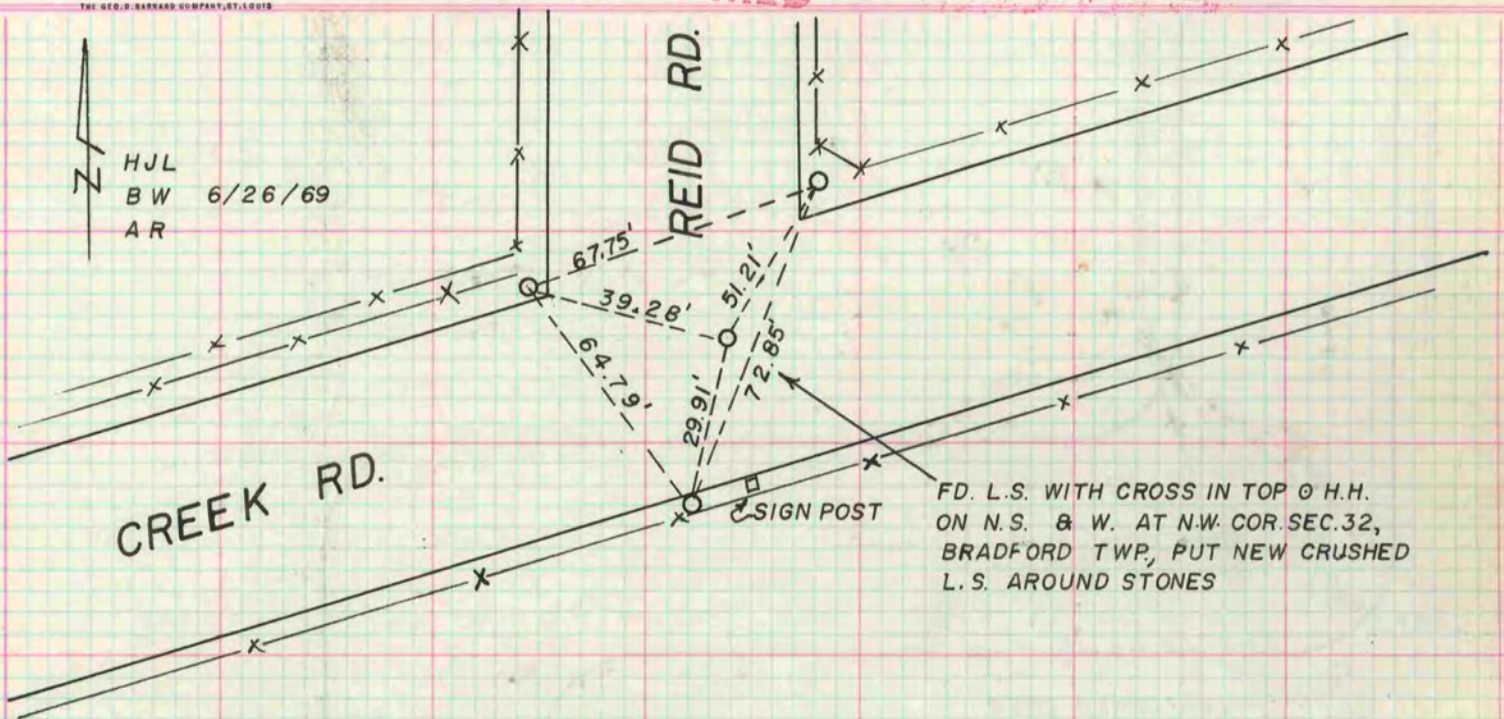

NOTE: ALL REFERENCES ARE 1" PIPES

