

# PLAT AND RECORD

485  
1-2

**MICROFILMED**

COUNTY BUILDING  
CITY OF JANESVILLE


Of a Survey on <sup>SW 1/4</sup> Section 6 T 2 R 14 E. of the 4 P. M. in Bradford Township

Rock County, Wisconsin, made Mar. the 12 1894

I hereby certify that the following is a correct record of said survey as made by me.

(Signed) O. G. Bleedorn

R. H. B. County Surveyor.

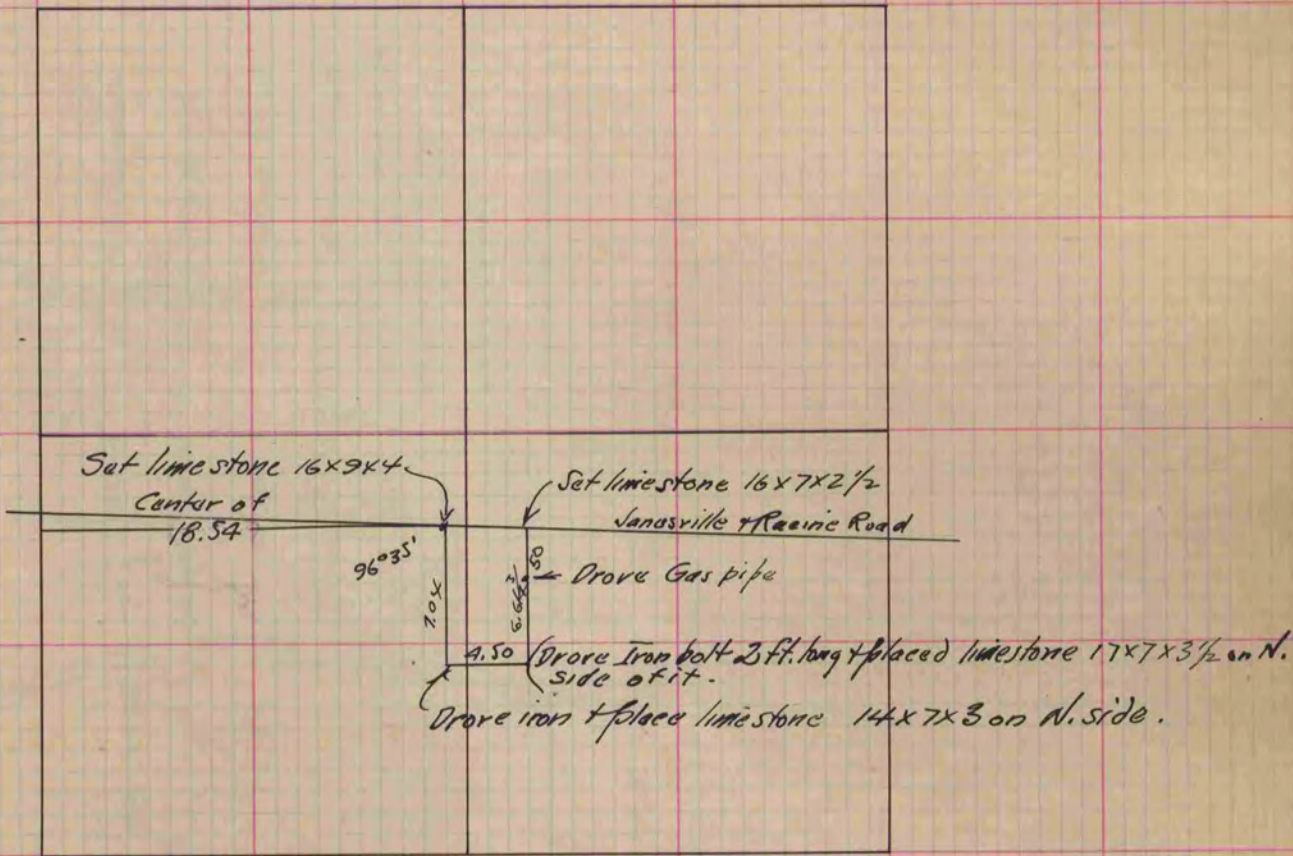

Copied from P. 376 Vol. 2. County Surveyors Record.