

# PLAT AND RECORD

Of a Survey on Section 14 T 2 N R 11 E. of the 4 P. M. in PLYMOUTH Township

Rock County, Wisconsin, made MAY the 11

I hereby certify that the following is a correct record of said survey as made by me,


COUNTY BUILDING  
CITY OF JANESVILLE



NW cor sec 14-2-11  
fd cut limestone. top broken  
and stone leaning at aprox. 45°  
angle. set alum mon.

MICROFILMED

DRAINAGE DITCH

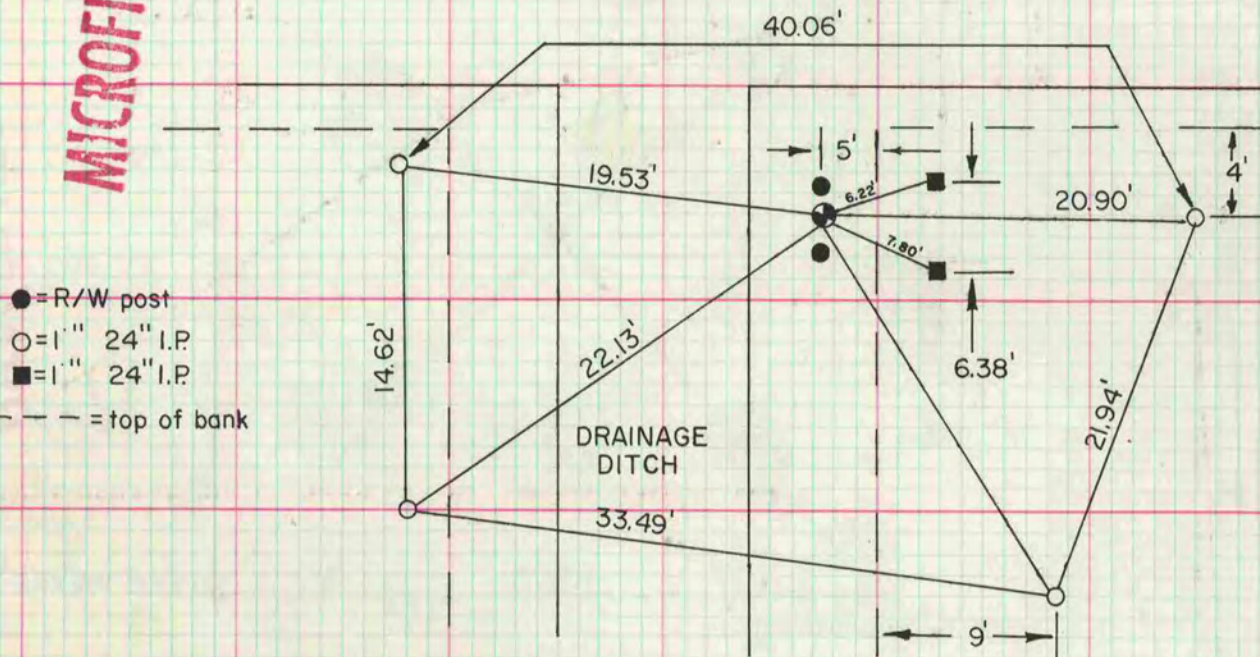

W 1/4 cor sec 14-2-11  
dug and fd cut limestone  
1.8' deep

SET ALUM MON  
MAY 20, 1978

