

PLAT AND RECORD

MICROFILMED

COUNTY BUILDING
CITY OF JANESVILLE


Of a Survey on Section 25 T 2 R 14 E. of the 4 P. M. in Bradford Township

Rock County, Wisconsin, made June the 18 1895

I hereby certify that the following is a correct record of said survey as made by me.

(Signed) P. F. Brown
R. H. B. County Surveyor.

Taken from notes of O. G. Bleedorn

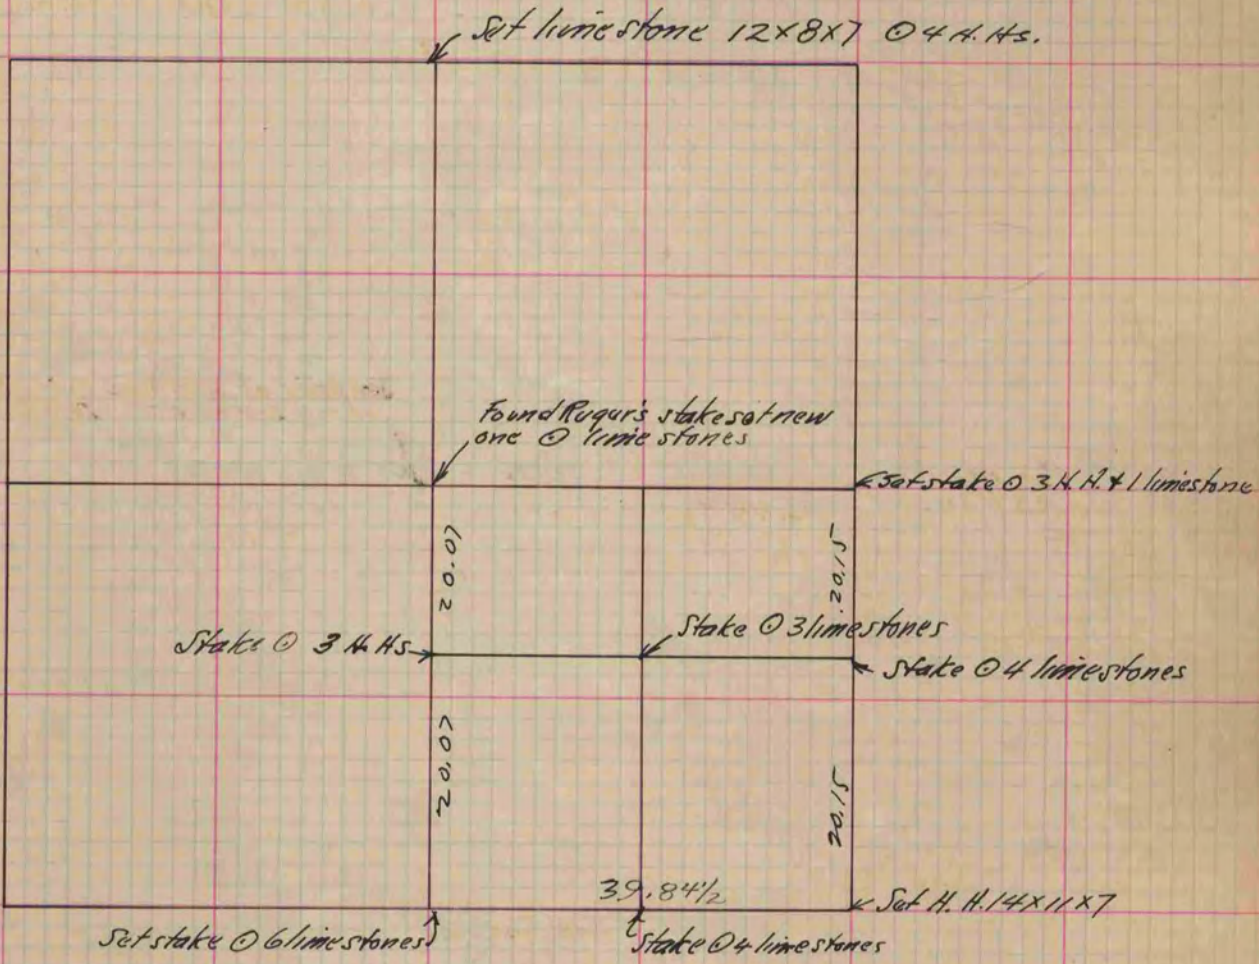

Copied from P. 380 Vol. 2. County Surveyors Record.