

# PLAT AND RECORD


Of a Survey on Section 20 25 T 4 R 11 E. of the 4 P. M. in PORTER Wisconsin Township  
 Rock County, Wisconsin, made APRIL the 29

I hereby certify that the following is a correct record of said survey as made by me.

COUNTY BUILDING  
CITY OF JANESVILLE



MICROFILMED

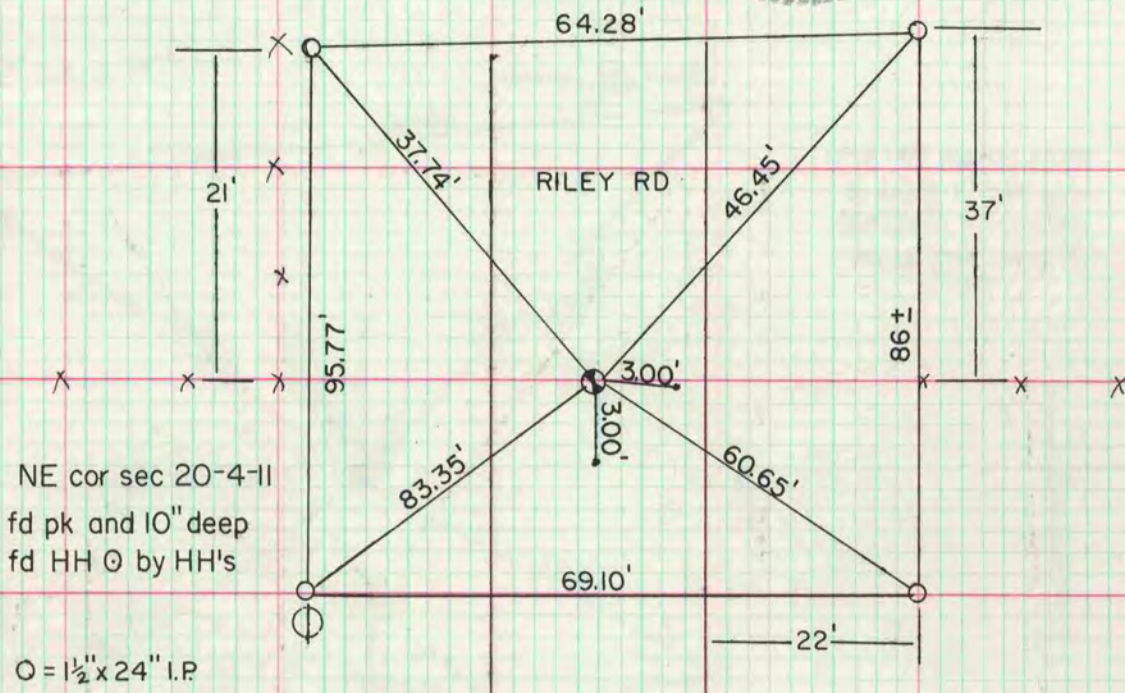

S 1/4 cor sec 25-4-11  
dug and fd nothing, set at  
single proportionate distance  
on line with SE and SW cors  
sec 25-4-11 set C.I. marker

