

MICROFILMED

# PLAT AND RECORD

Of a Survey on Section 14 T 3 R 13 E. of the 4 P. M. in Harmony Township


Rock County, Wisconsin, made March 17<sup>th</sup> 1875 & April 1875 the 23 1879

I hereby certify that the following is a correct record of said survey as made by me.

COUNTY BUILDING  
CITY OF JANESVILLE

(Signed) Edward Ruger  
R.H.B.

County Surveyor.

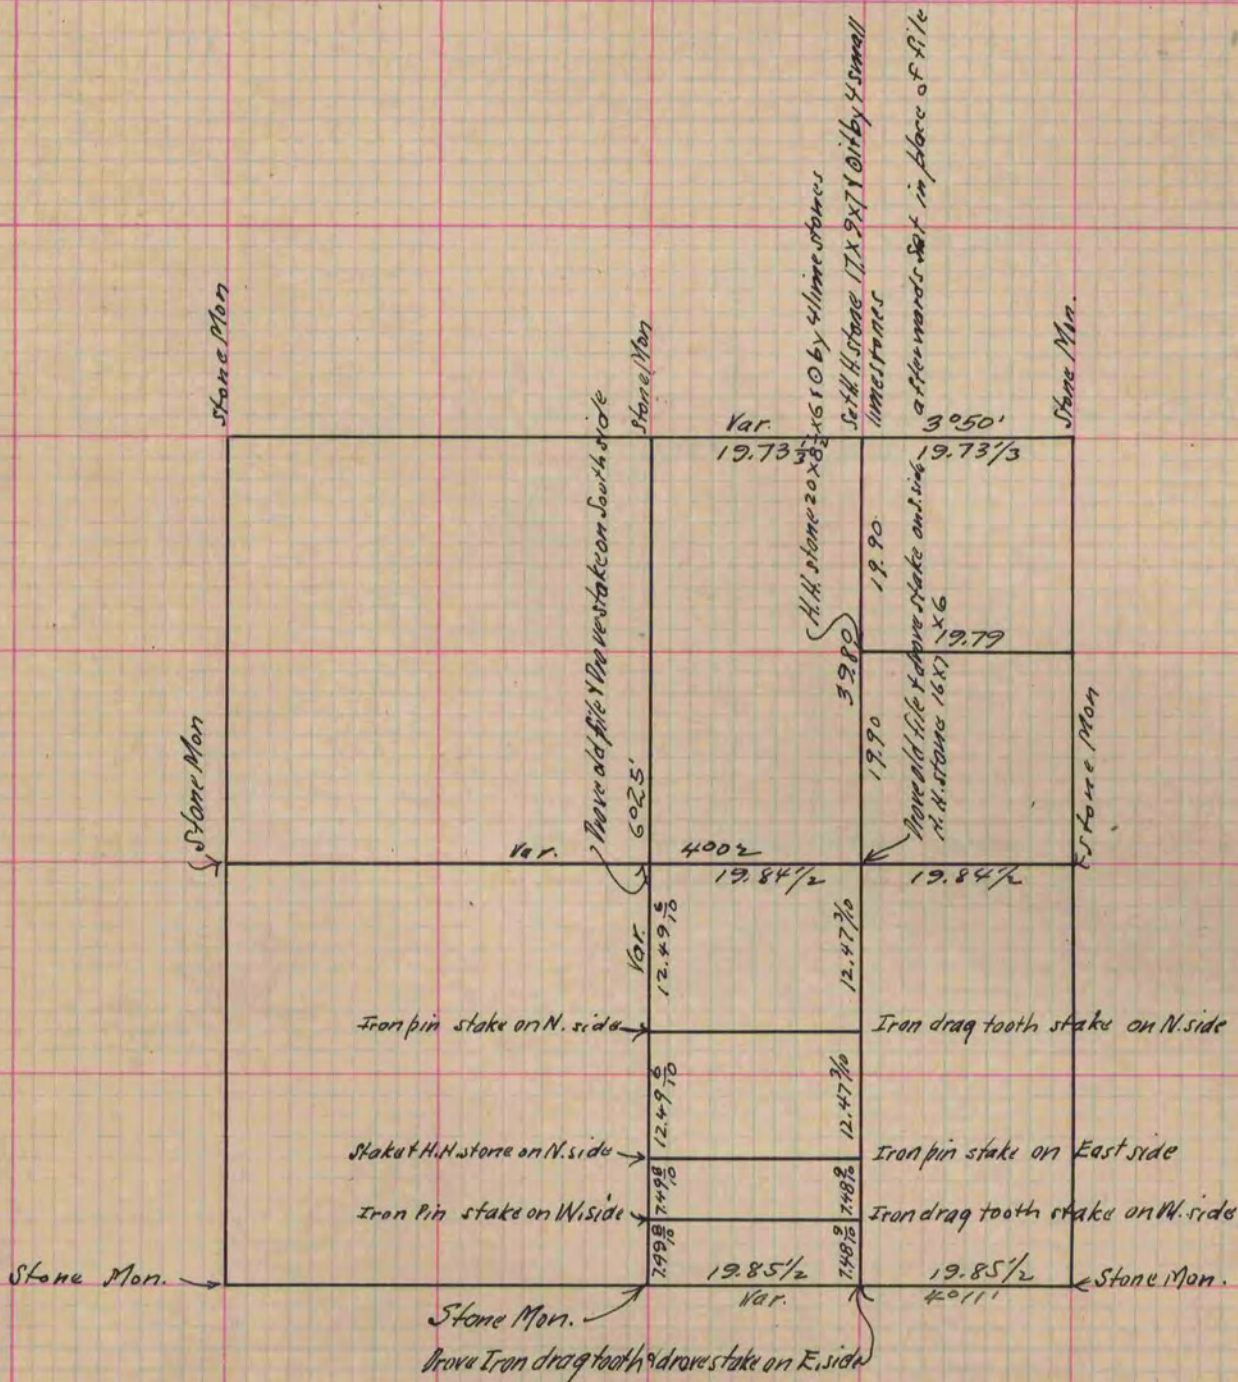

Copied from Page 138 Vol. 2. Original County Surveyors Record