

# PLAT AND RECORD


## MICROFILMED

Of a Survey on Section 17 T 3 R 10 E. of the 4 P. M. in Magnolia Township  
 Rock County, Wisconsin, made May the 26, 27 & 28 1870

I hereby certify that the following is a correct record of said survey as made by me.

COUNTY BUILDING  
 CITY OF JANESVILLE

(Signed) Edward Roger Deputy  
 R.H.B. County Surveyor.

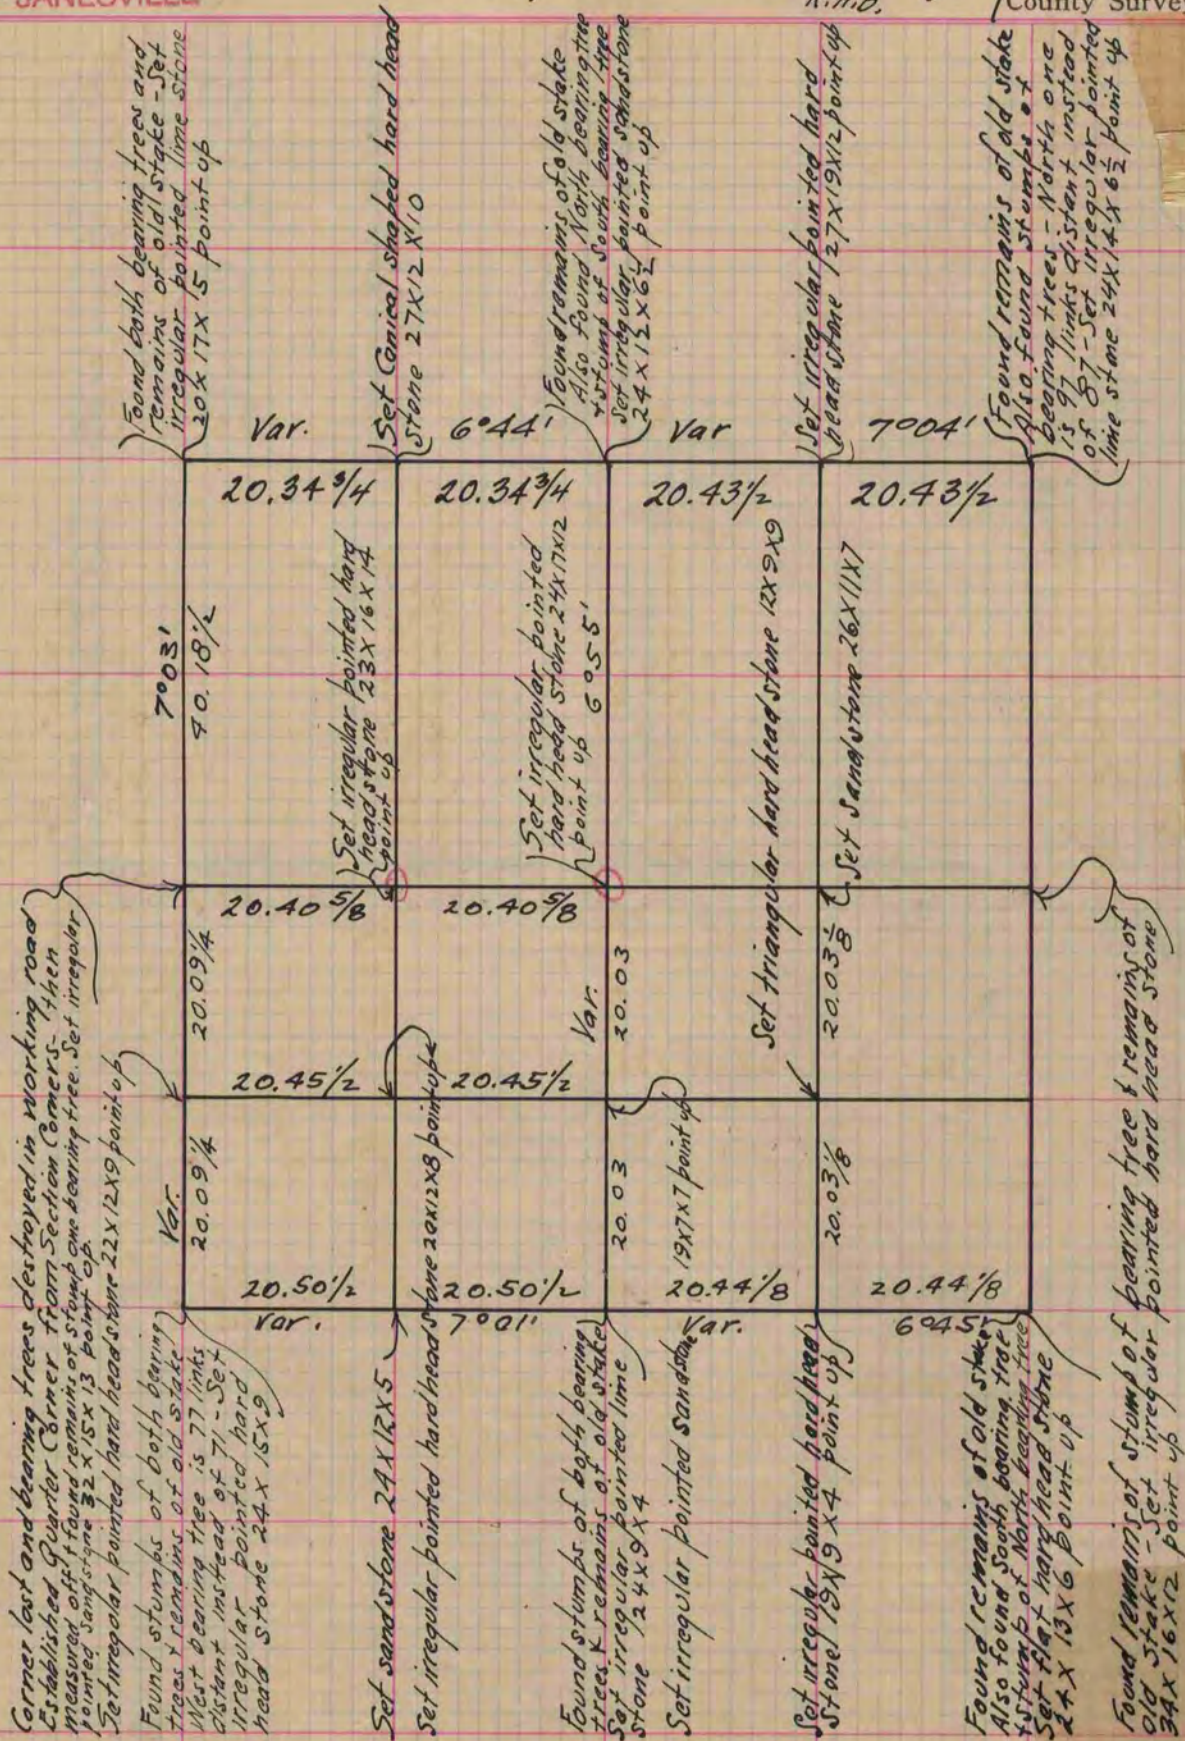

Copied from Page 21 Vol. 2 Original County Surveyors Record