


PLAT AND RECORD

Of a Survey on Section 5 T 1 R 11 E. of the 4 P. M. in Newark Township
Rock County, Wisconsin, made April the 11, 12 & 13 1878

I hereby certify that the following is a correct record of said survey as made by me.

COUNTY BUILDING
CITY OF JANESVILLE

(Signed) Edward Ruger
R. H. B. County Surveyor.

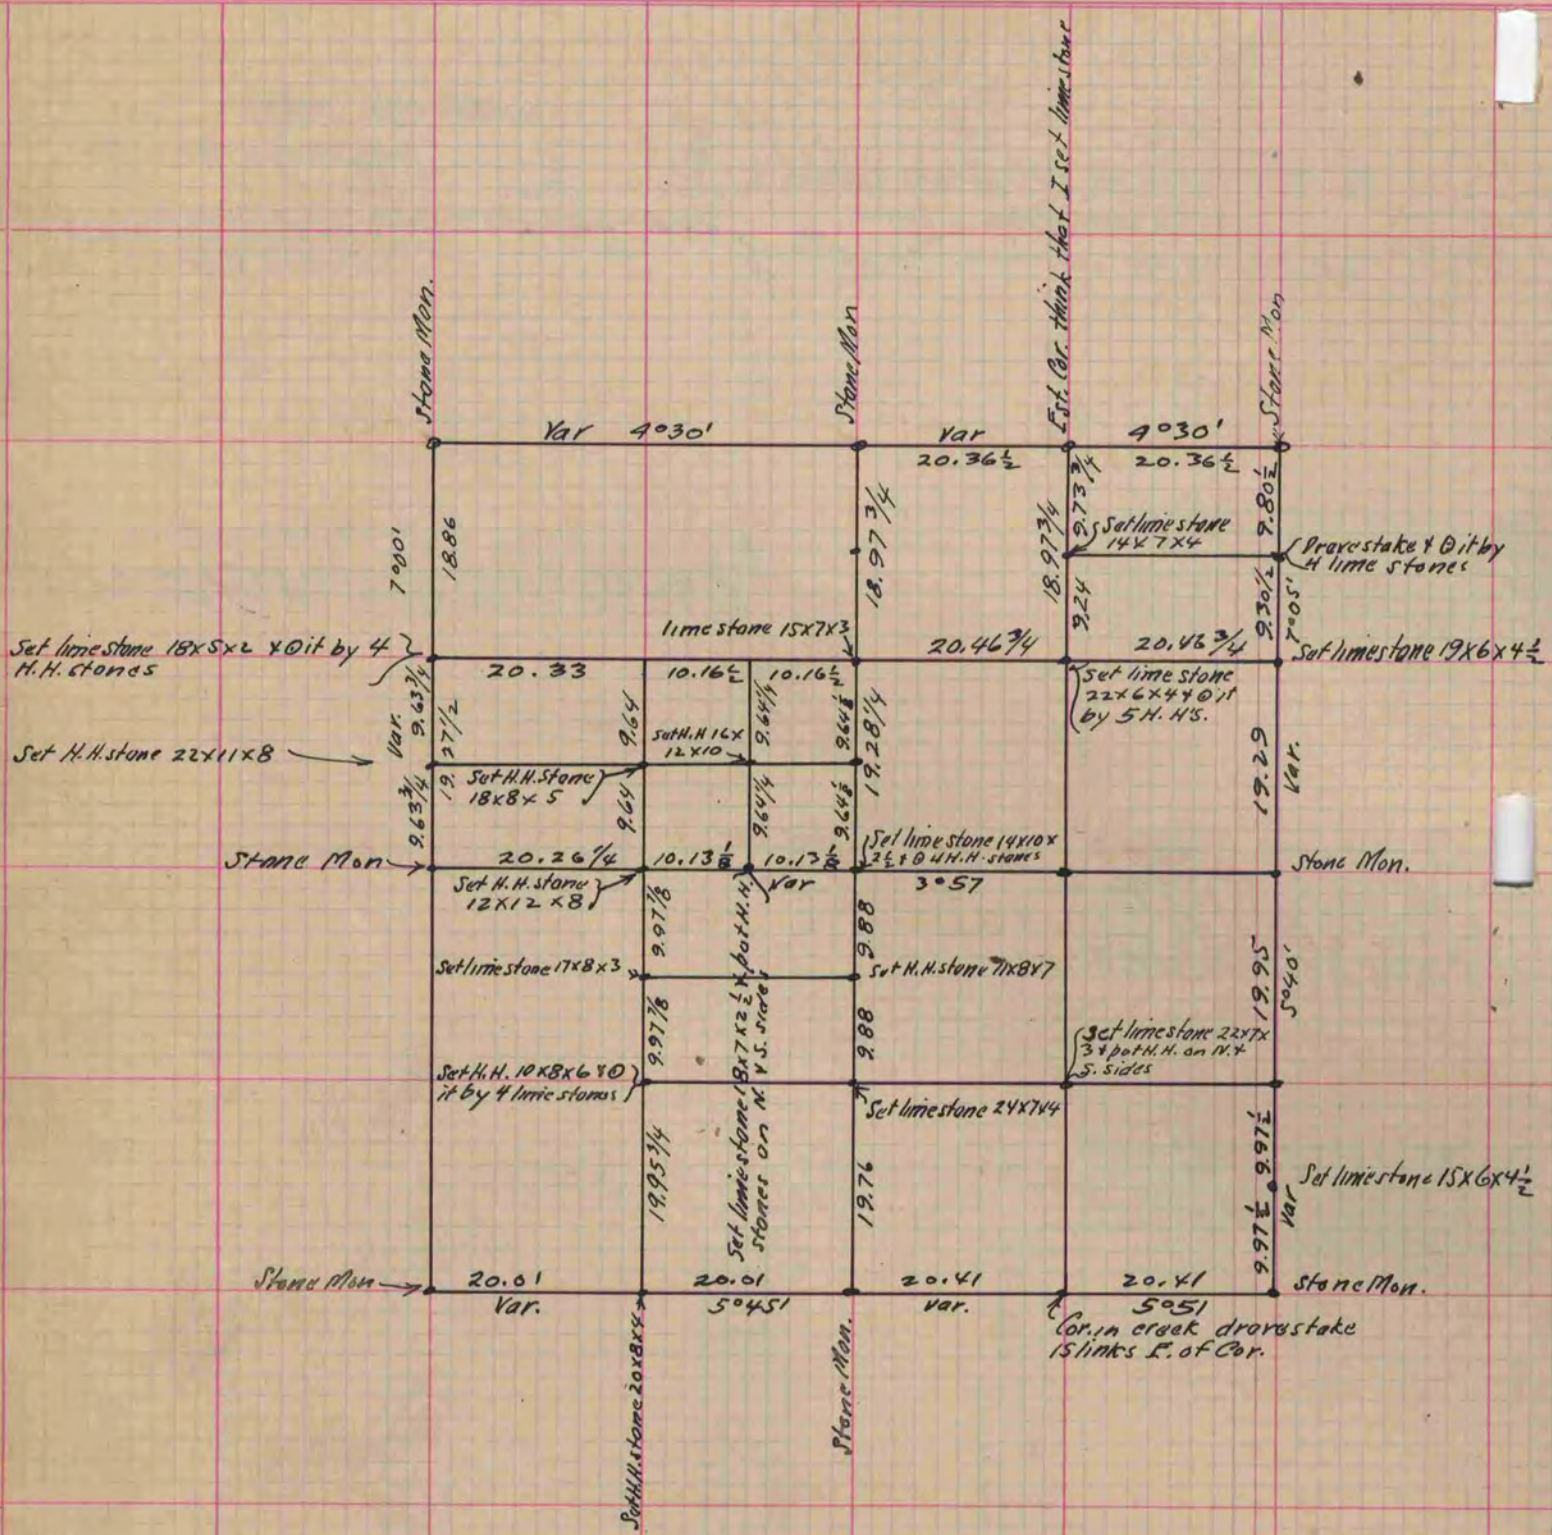

Copied from P. 198 Vol. 2 County Surveyors Record.