

PLAT AND RECORD

221

VOL. 6

Of a Survey on Section 17, 18 T 2 R 14 E. of the 4 P. M. in BRADFORD Township

Rock County, Wisconsin, made October the 1981

I hereby certify that the following is a correct record of said survey as made by me.

COUNTY BUILDING
CITY OF JANESVILLE



County Surveyor.

SE COR SEC 17

MYLAR MAP RECEIVED FROM FORMER COUNTY SURVEYOR INDICATES THE CORNER WAS DUG FOR AND NOTHING FOUND. SET ALUM MONUMENT AT PROPORTIONATE DISTANCE FROM ADJACENT CORNERS. THIS IS IN HARMONY WITH OCCUPATION



E 1/4 COR SEC 26


FOUND 1" IP. DROVE DEEP & SET 2X30" IP ON TOP, IP IS WITHIN A FEW INCHES OF THE FENCE POST

SW COR SEC 18

FOUND CUT LIMESTONE SET CARSONITE POST


S 1/4 COR SEC 17

DUG AND FOUND STAKE REPLACED WITH W-1-C POLYSTYRENE MON

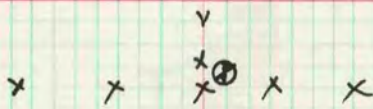

SW COR SEC 17

DUG & FOUND NOTHING. SET PROPORTIONATE DISTANCE FROM ADJACENT CORNERS SET ALUM MON

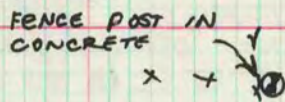

N 1/4 COR SEC 35

FOUND 1" GP @ 4 LIMESTONE REPLACED IP WITH W-1-C POLYSTYRENE MON & SET CARSONITE POST



MICROFILMED