

V-2 MICROFILMED

PLAT AND RECORD

COUNTY BUILDING
CITY OF JANESVILLE

Of a Survey on Section *S.E. 1/4 36* T 1 R 12 E. of the 4 P. M. in *Beloit* Township


Rock County, Wisconsin, made *July* the *21, 22 & 24* 1874

I hereby certify that the following is a correct record of said survey as made by me.

COUNTY BUILDING
CITY OF JANESVILLE

(Signed) *Edward Ruger*
R.H.B.

County Surveyor.

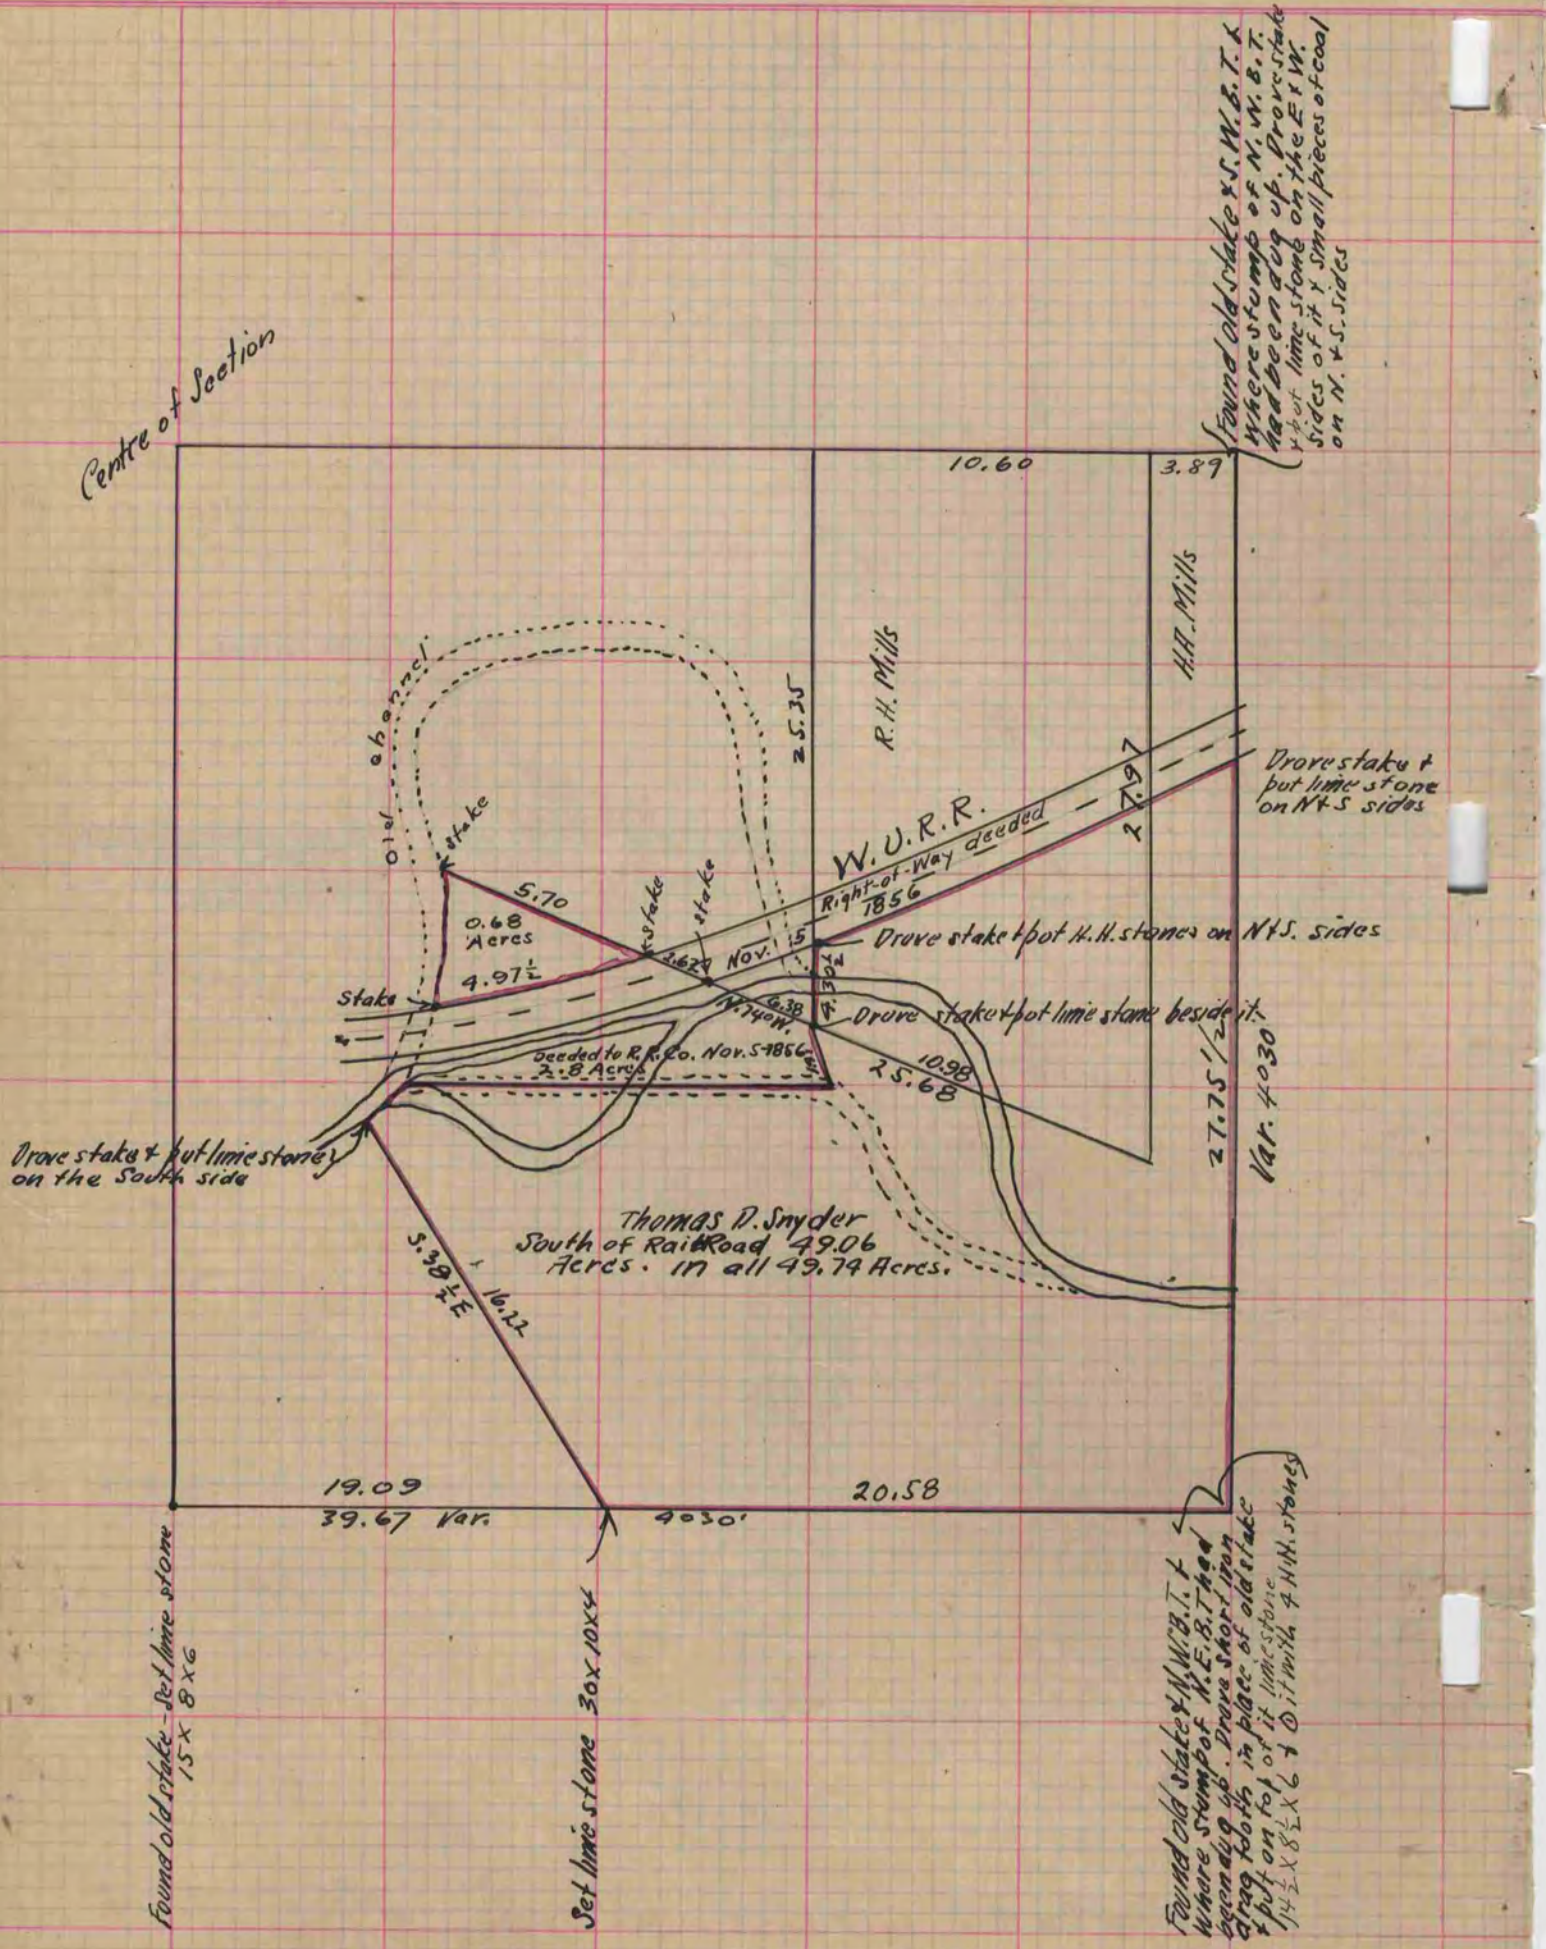

Copied from Page 105 Vol. 2. Original County Surveyors Record.