

PLAT AND RECORD

MICROFILMED

Of a Survey on Section 31 T 1 R 10 E. of the 4 P. M. in Avon Township


Rock County, Wisconsin, made _____ the _____ 19____

I hereby certify that the following is a correct record of said survey as made by me.

COUNTY BUILDING
CITY OF JANESVILLE

(Signed) Edward Ruger
R.H.B.

County Surveyor.

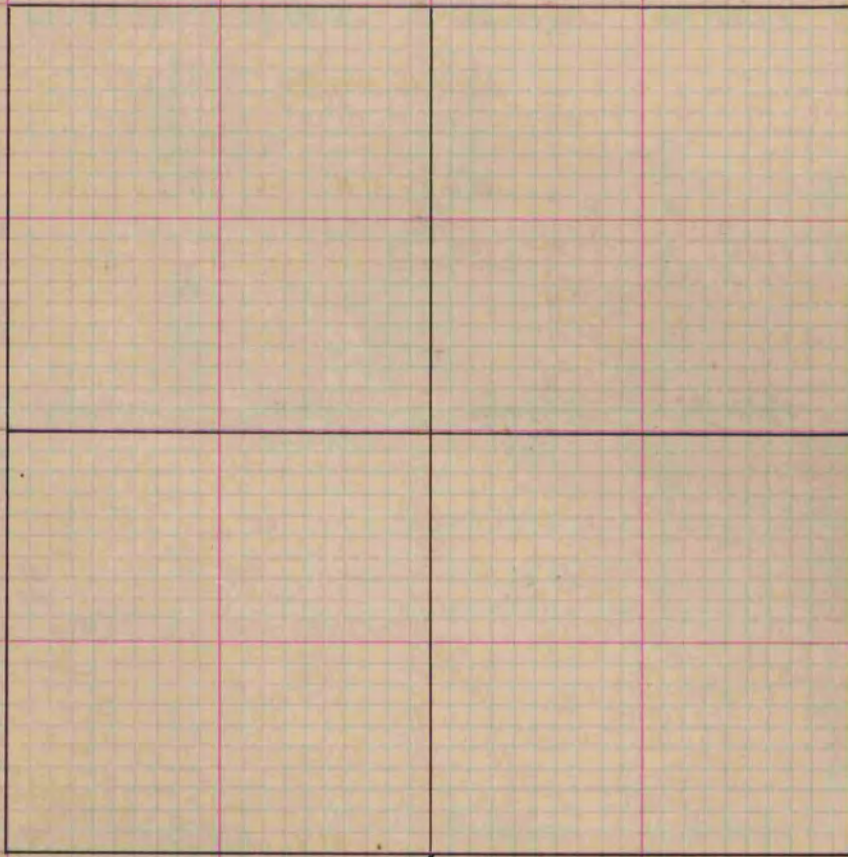

Found stump of N.W. B.T. Stump of N.E. B.T.
washed out. Drove stake & Oil by 3
H.H. Stones

Copied from page 202 Vol. 2 County Surveyors Record.