

4  
V-2  
**MICROFILMED**


# PLAT AND RECORD

Of a Survey on Section 13 T 2 R 12 E. of the 4 P. M. in Rock Township  
Rock County, Wisconsin, made November the 1<sup>st</sup> 1869

I hereby certify that the following is a correct record of said survey as made by me.

COUNTY BUILDING  
CITY OF JANESVILLE

(Signed) R. K. Lee Deputy  
R. H. B. County Sur

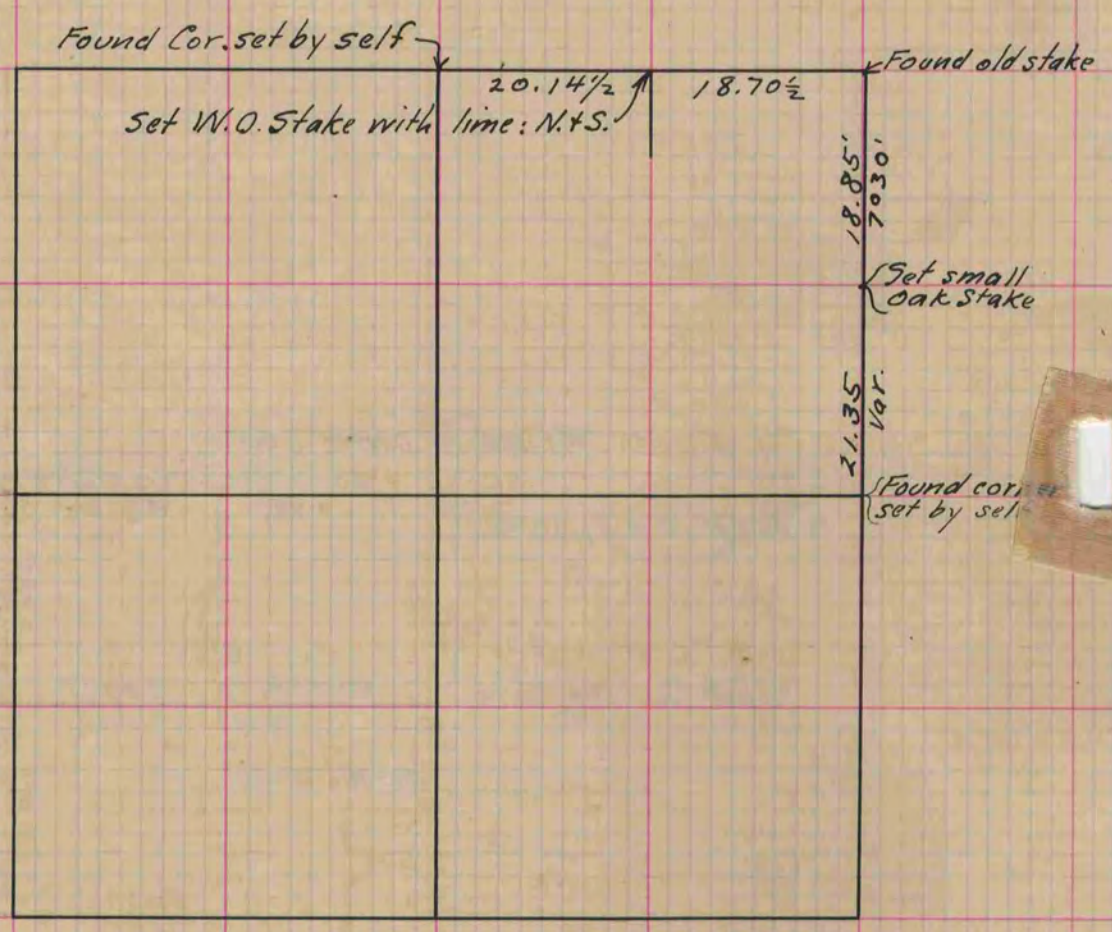

*Copied from lower 1/2 of Page 8 Vol. 2. Original County Surveyors Record*