

MICROFILMED

# PLAT AND RECORD


COUNTY BUILDING  
CITY OF JANESVILLE

Of a Survey on Section 4 T 3 R 13 E. of the 4 P. M. in Harmony Township

Rock County, Wisconsin, made April the 1866

I hereby certify that the following is a correct record of said survey as made by me.

(Signed) S. D. Locke  
(R.H.B.) County Surveyor.

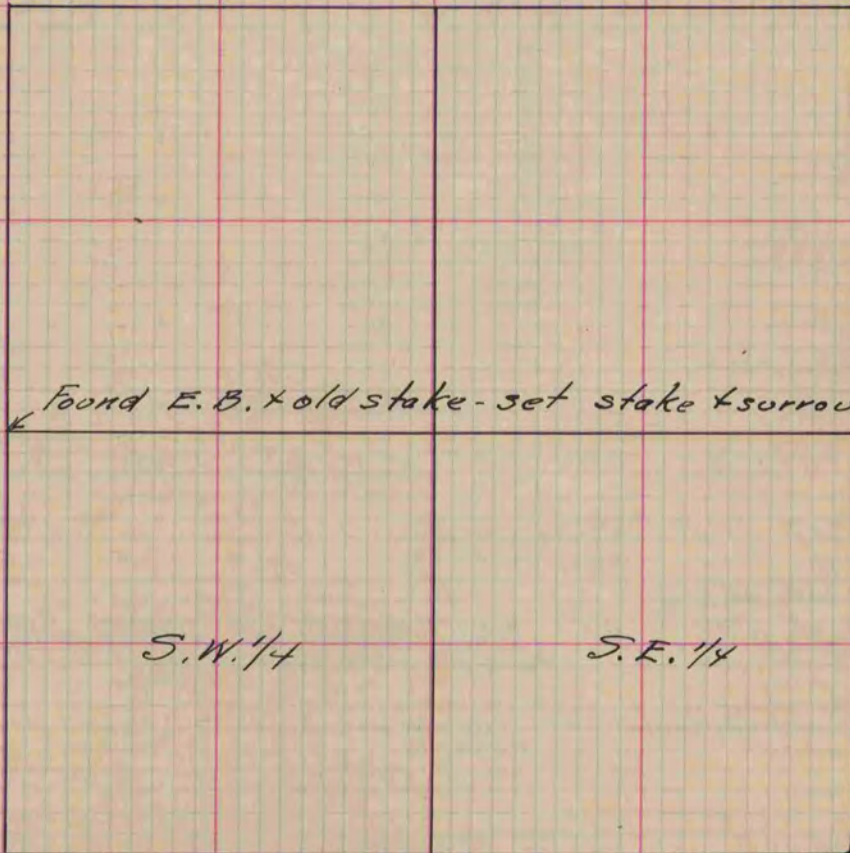

*Copied from Page 226 Vol. 1. Original County Surveyors Record*