

MICROFILMED

PLAT AND RECORD

409

V-2

COUNTY BUILDING
CITY OF JANESVILLE


Of a Survey on Section 7 T 3 R 14 E. of the 4 P. M. in Johnstown Township

Rock County, Wisconsin, made May the 3 1883

I hereby certify that the following is a correct record of said survey as made by me.

(Signed) Edward Ruger
R. H. B

County Surveyor.

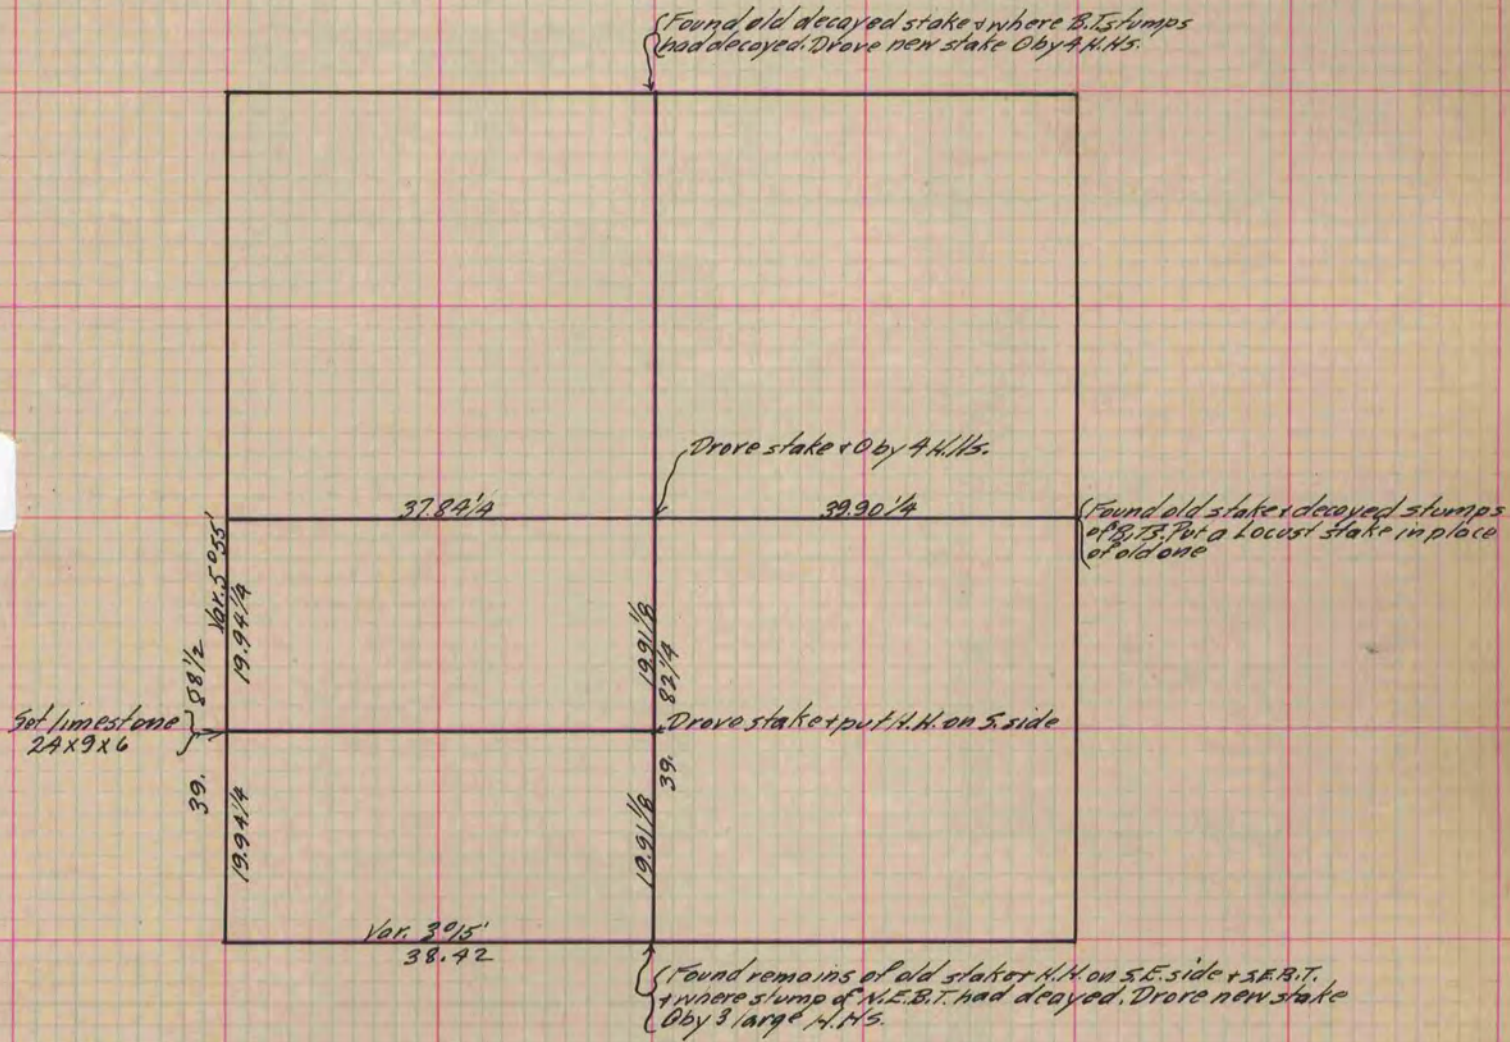

Copied from P. 331 Vol. 2 County Surveyor's Record.