

MICROFILMED

PLAT AND RECORD

421
V-2


COUNTY BUILDING
CITY OF JANESVILLE

Of a Survey on Section 2 T 1 R 10 E. of the 4 P. M. in Avon Township

Rock County, Wisconsin, made May the 23rd 1888

I hereby certify that the following is a correct record of said survey as made by me.

(Signed) R. K. Lee Dep.
R. H. B. County Surveyor.

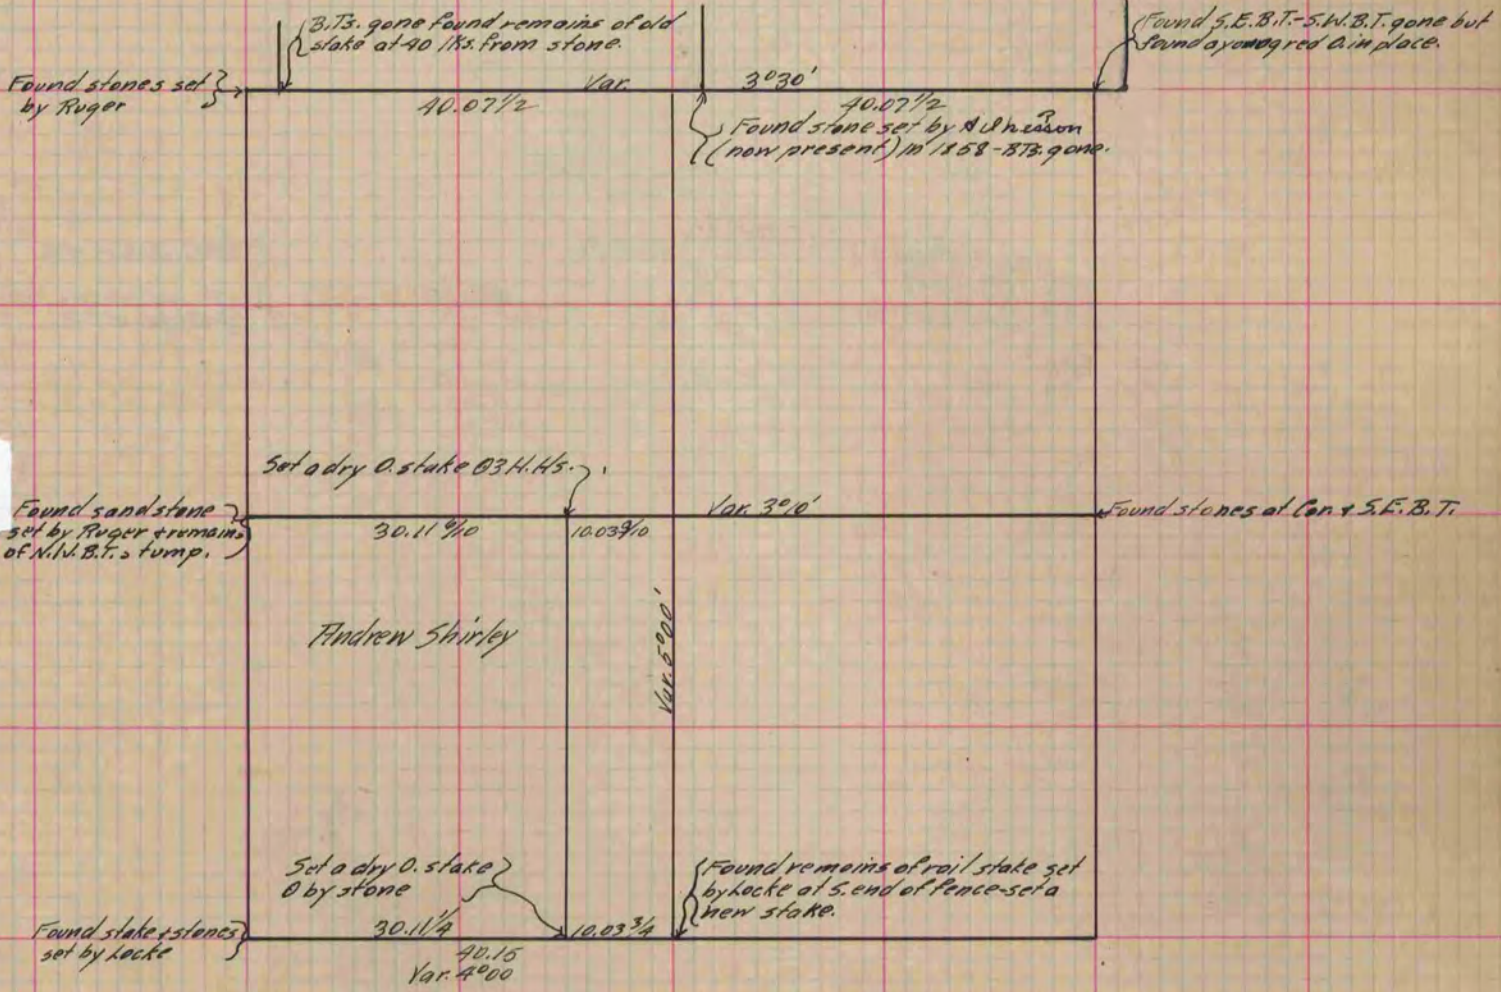

Copied from P. 340 Vol. 2 County Surveyor's Record.