


MICROFILMED PLAT AND RECORD

Of a Survey on Section 1 T 3 R 14 E. of the 4 P. M. in Johnstown Township
Rock County, Wisconsin, made December the 6th 1887

I hereby certify that the following is a correct record of said survey as made by me.

COUNTY BUILDING
CITY OF JANESVILLE

(Signed) Edward Ruger
R.H.B. County Surveyor.

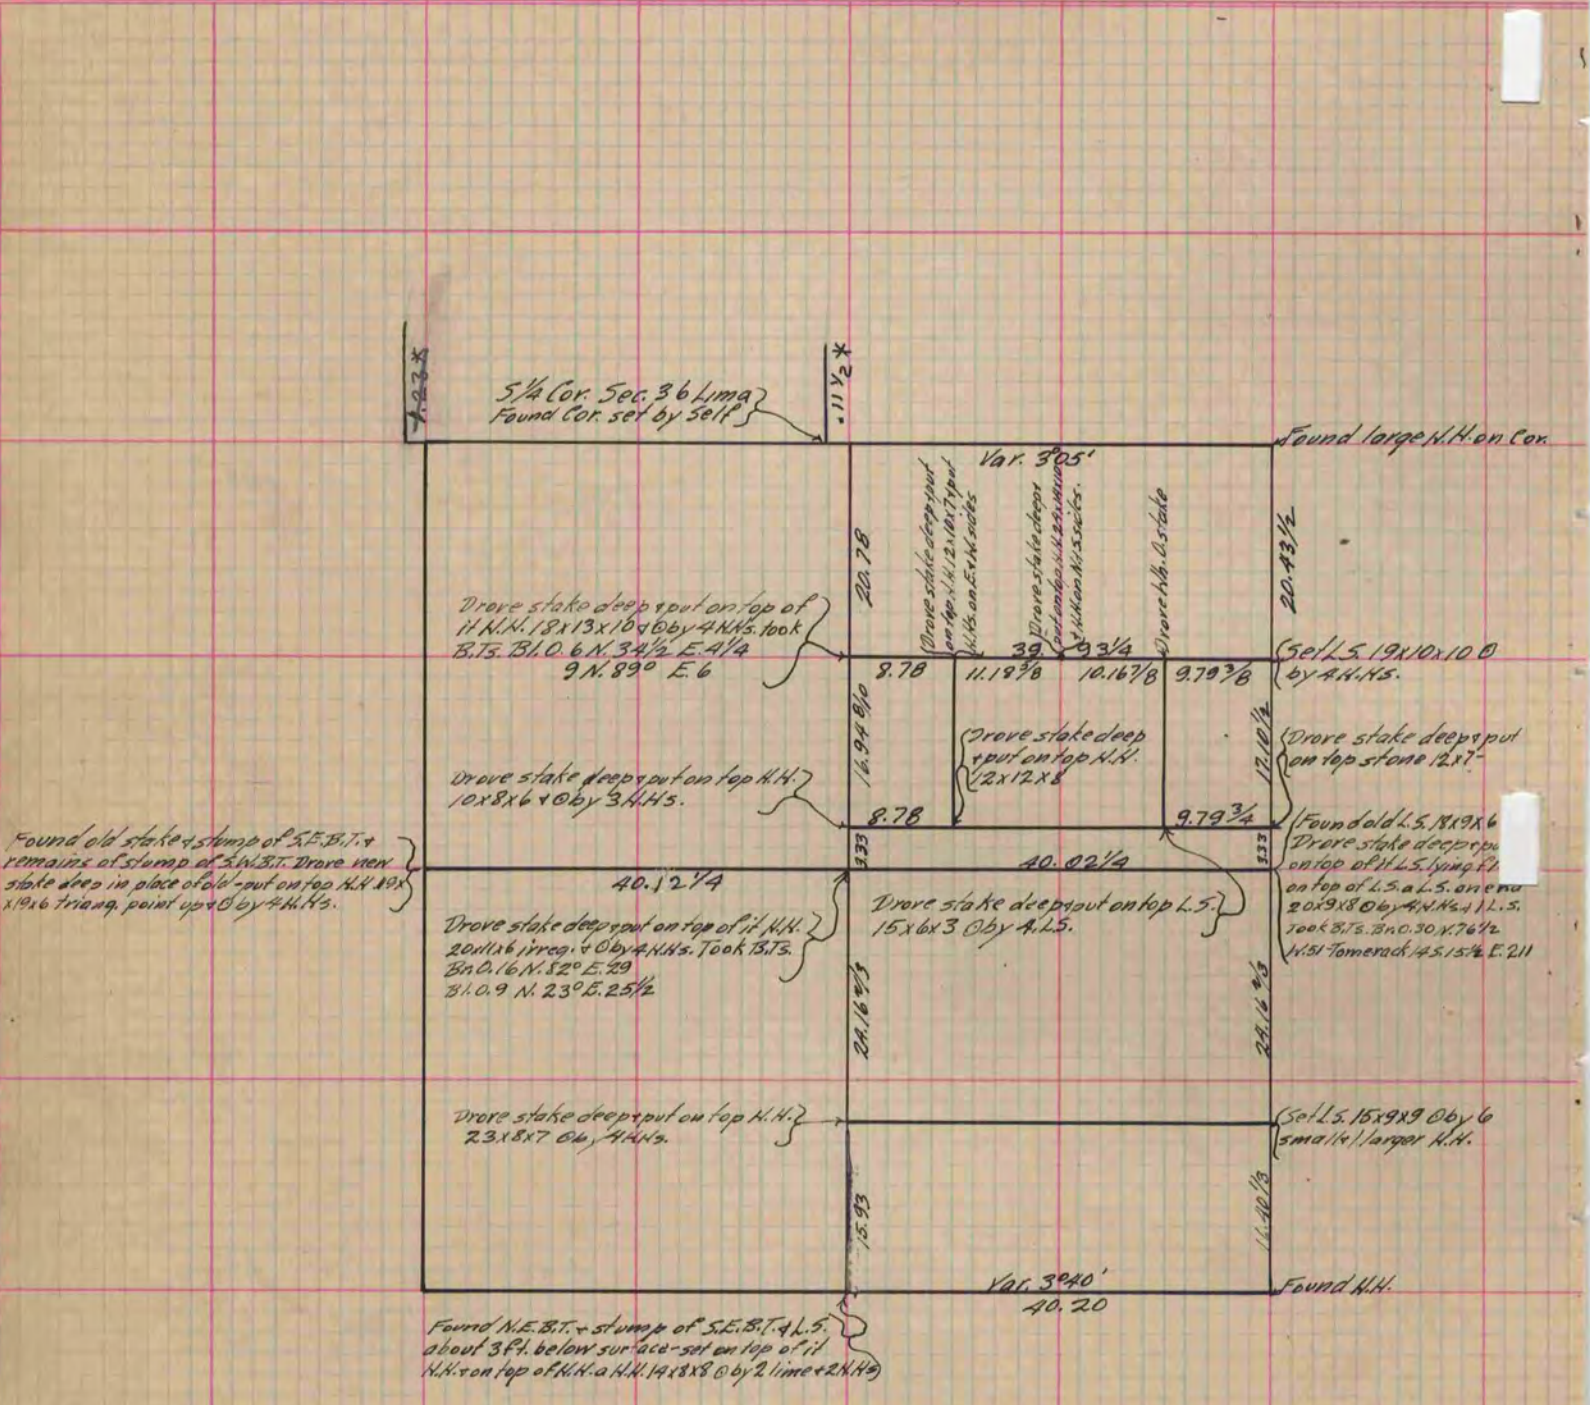

Copied from P. 339 Vol. 2 County Surveyor's Record.

* Copied FROM COUNTY SURVEY RECORD VOLUME E 1859-1906