


PLAT AND RECORD

Of a Survey on Section 3 T 3 R 12 E. of the 4 P. M. in Janesville Township
Rock County, Wisconsin, made January the 29+30 1878

I hereby certify that the following is a correct record of said survey as made by me.

COUNTY BUILDING
CITY OF JANESVILLE

(Signed) Edward Rugev
R. H. B. County Surveyor.

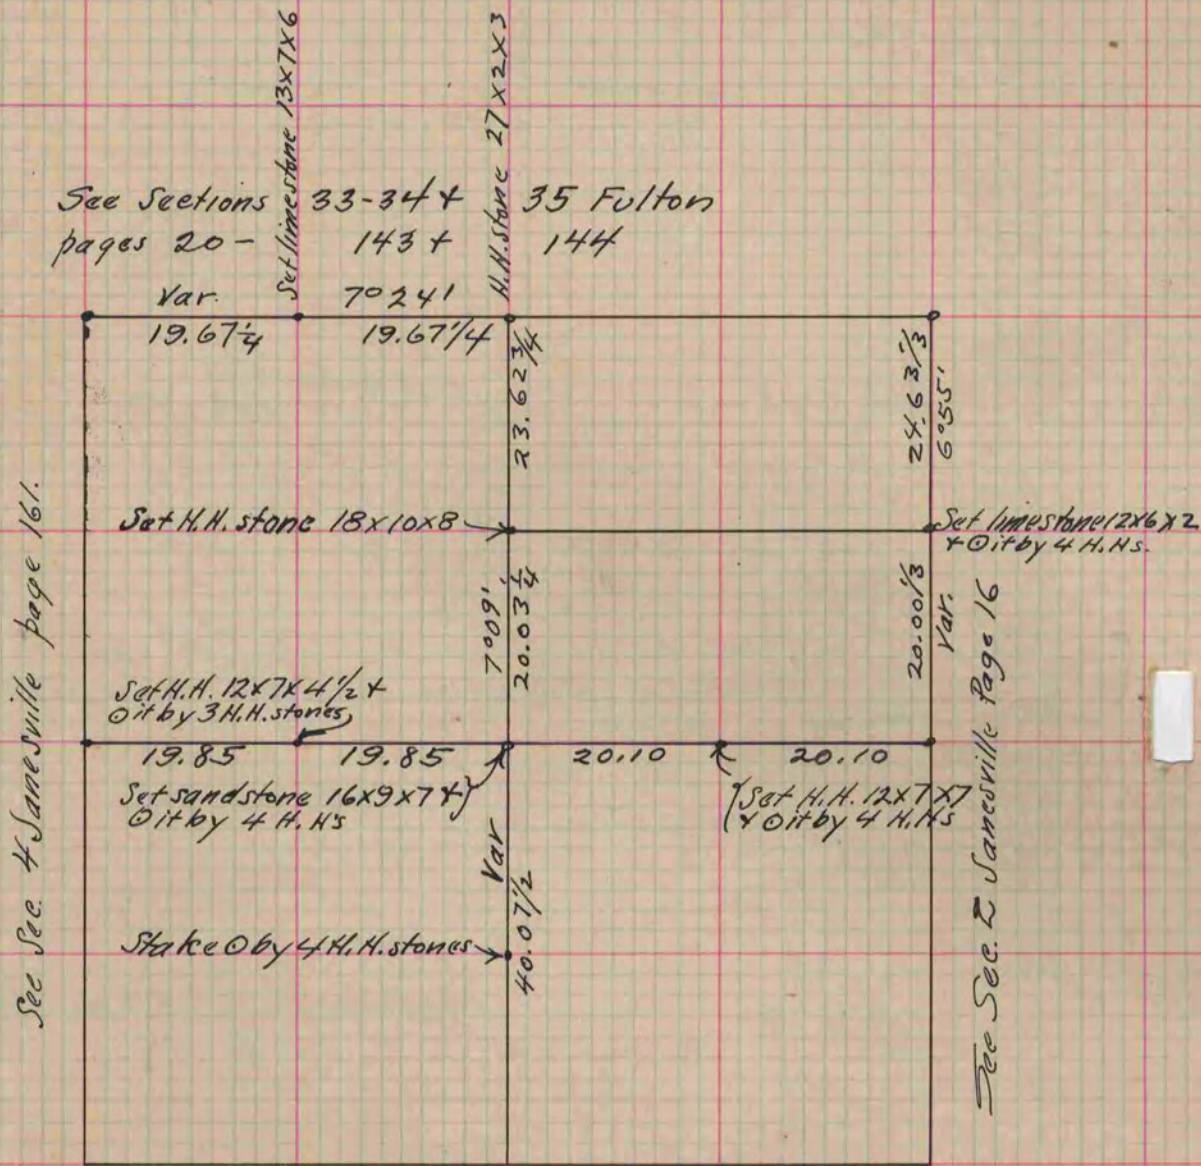

See Section 10 Janesville page 15

Copied from Page 194 Volume 2 County Surveyors Record