

MICROFILMED

PLAT AND RECORD

401
V-2

COUNTY BUILDING
CITY OF JANESVILLE


Of a Survey on Section 35 T 3 R 12 E. of the 4 P. M. in Janesville Township

Rock County, Wisconsin, made April the 1st 1882

I hereby certify that the following is a correct record of said survey as made by me.

(Signed) *Edward Ruger*
R.H.B.

County Surveyor.

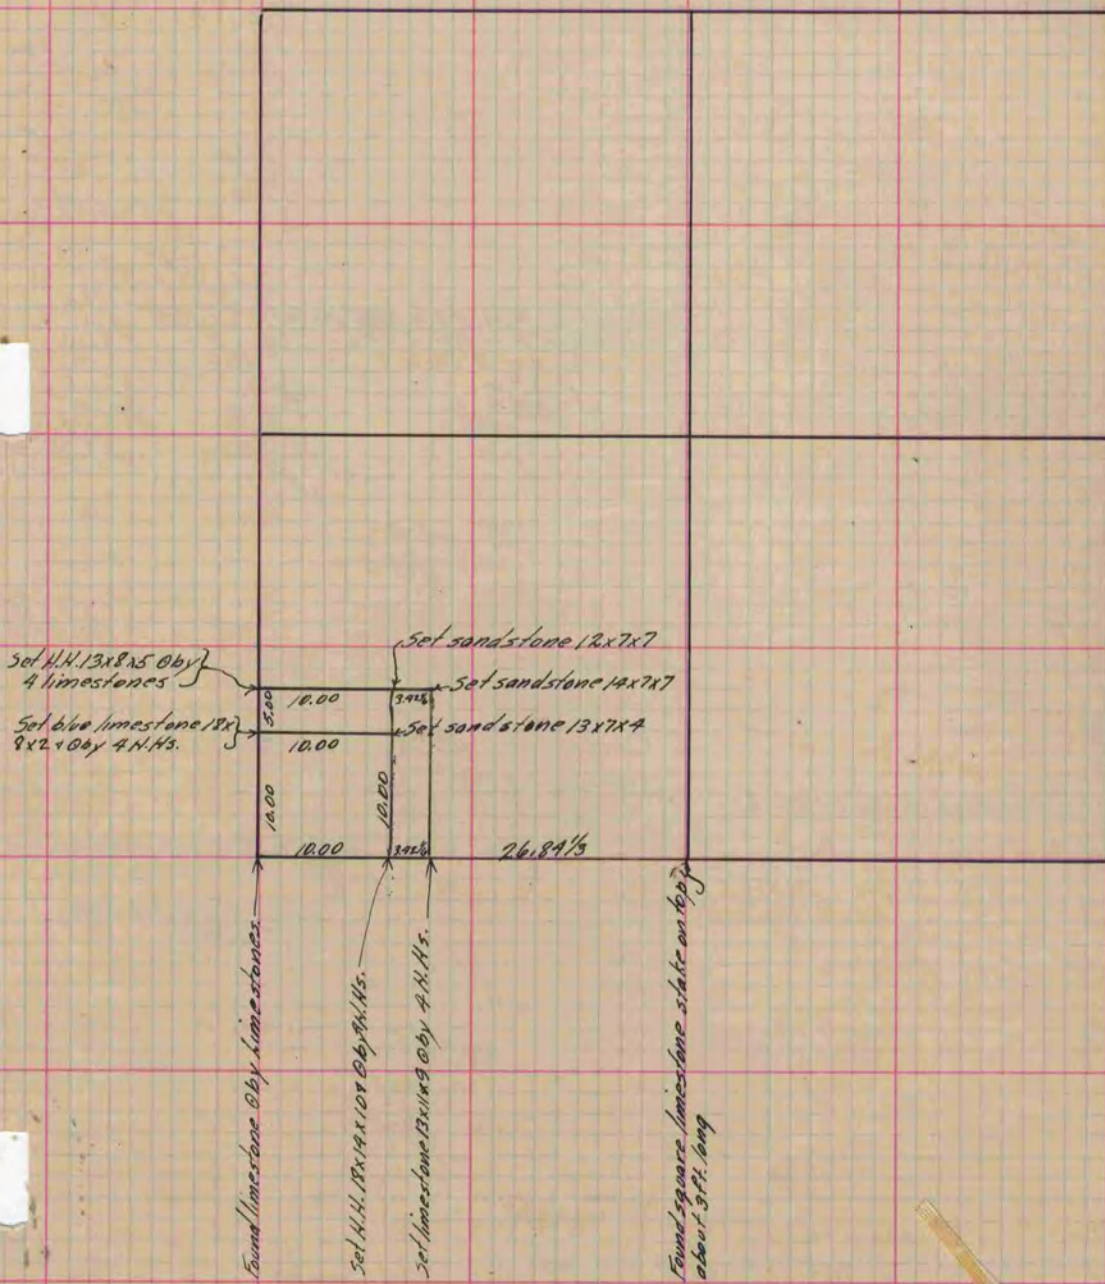

Copied from P. 223 Vol. 2 County Surveyor's Record.