

MICROFILMED

PLAT AND RECORD

COUNTY BUILDING
CITY OF JANESVILLE


249
V-2

Of a Survey on Section 22 T 3 R 14 E. of the 4 P. M. in Johnstown Township

Rock County, Wisconsin, made June 28-1878 & January the 12 1886

I hereby certify that the following is a correct record of said survey as made by me.

(Signed) Edward Ruger
R.H.B. County Surveyor.

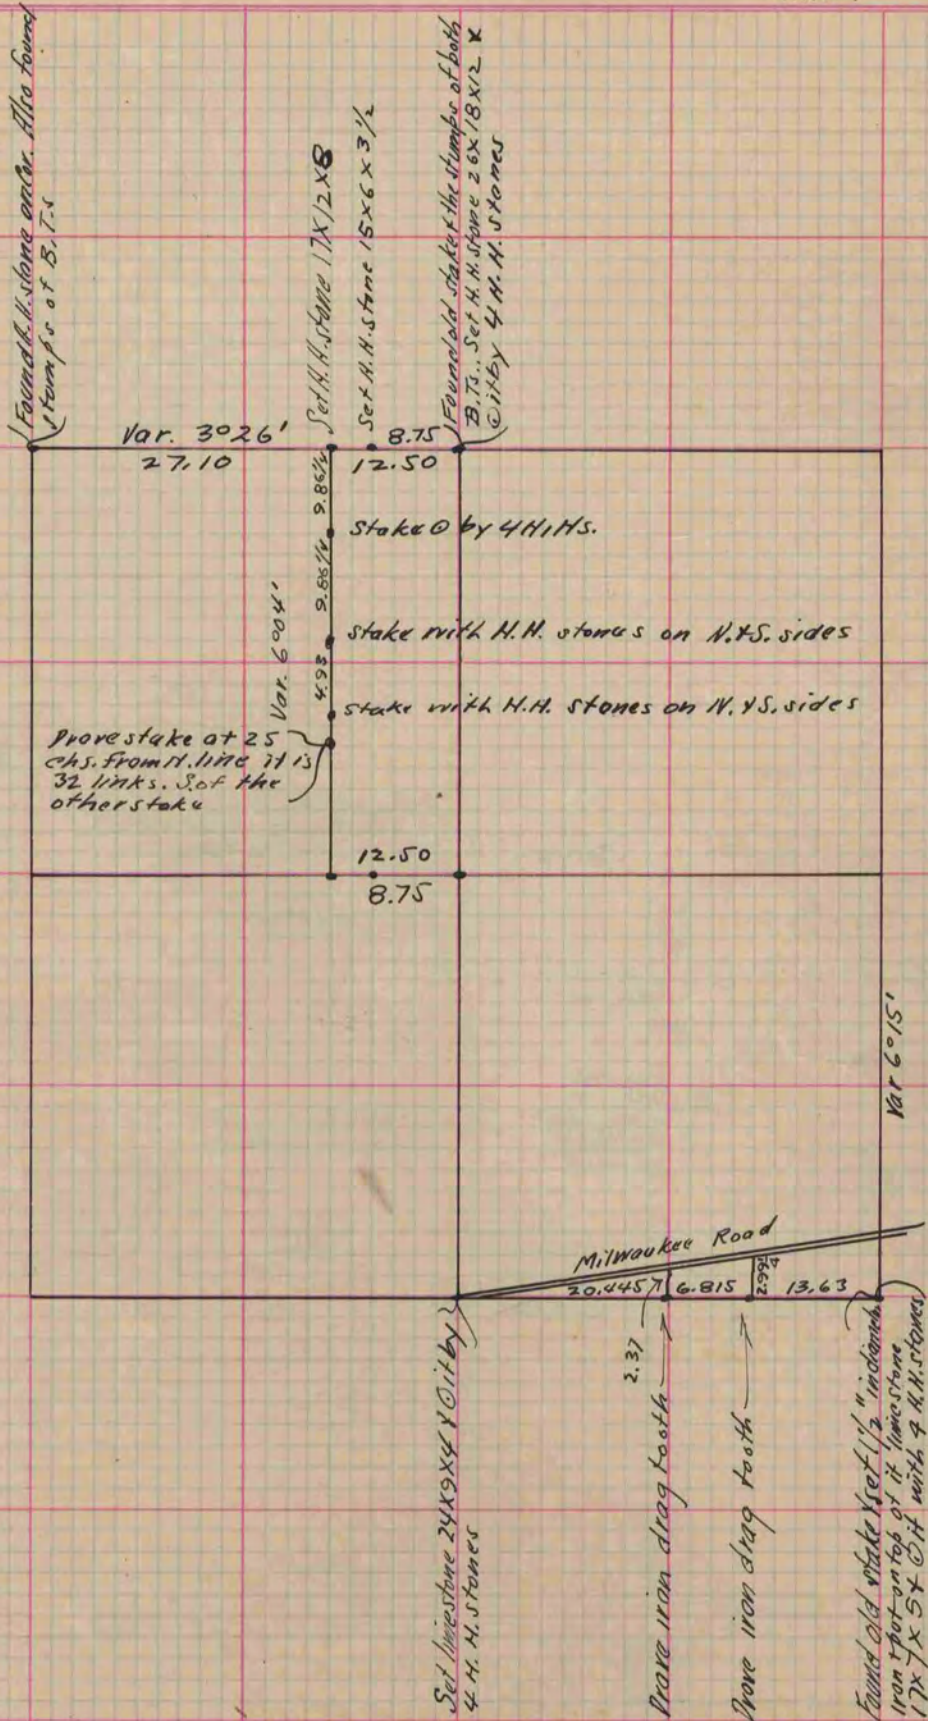

Copied from page 203 Vol. 2 County Surveyors Record