

MICROFILMED PLAT AND RECORD

Of a Survey on Section 17 T A R 14 E. of the 4 P. M. in Lima Township
Rock County, Wisconsin, made the _____ 19____


I hereby certify that the following is a correct record of said survey ~~as made by me.~~

COUNTY BUILDING
CITY OF JANESVILLE

(Signed) P. F. Brown
R.H.B.

County Surveyor

Bleedorn Survey

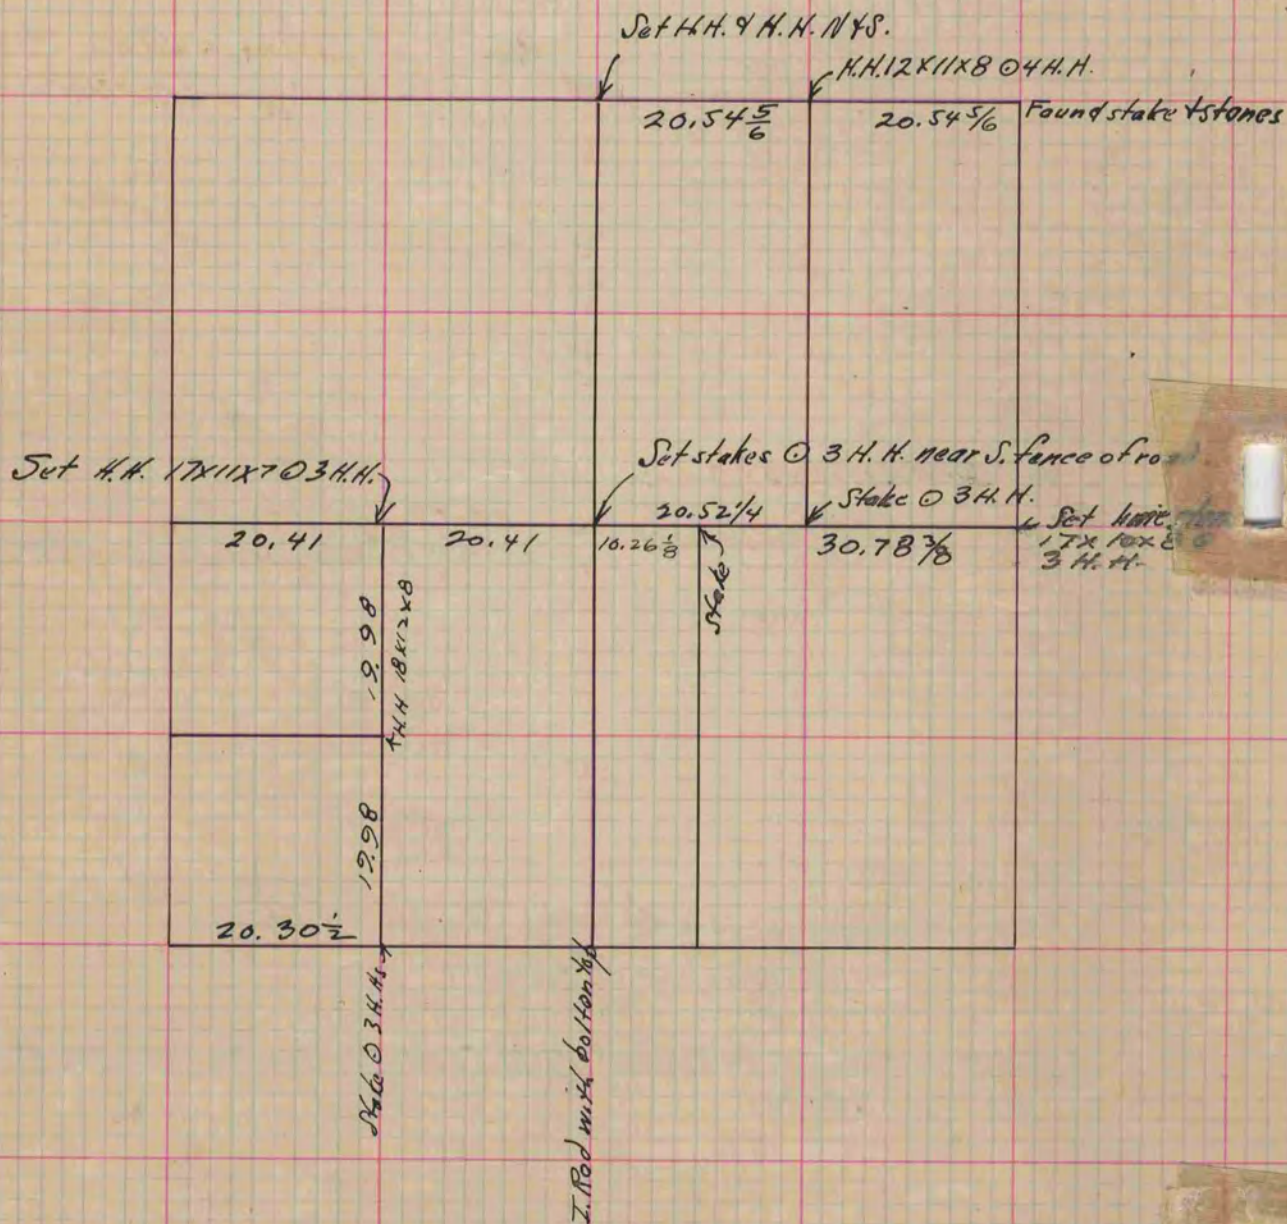

Copied from P. 379 Vol. 2. County Surveyors Record