

PLAT AND RECORD

COUNTY BUILDING
CITY OF JANESVILLE

Of a Survey on Section 14 T 4 R 13 E. of the 4 P. M. in MILTON Township


Rock County, Wisconsin, made JULY the 7th 1975

I hereby certify that the following is a correct record of said survey as made by me. ^{DAB}

MICROFILMED

Donald A Barnes

County Surveyor.

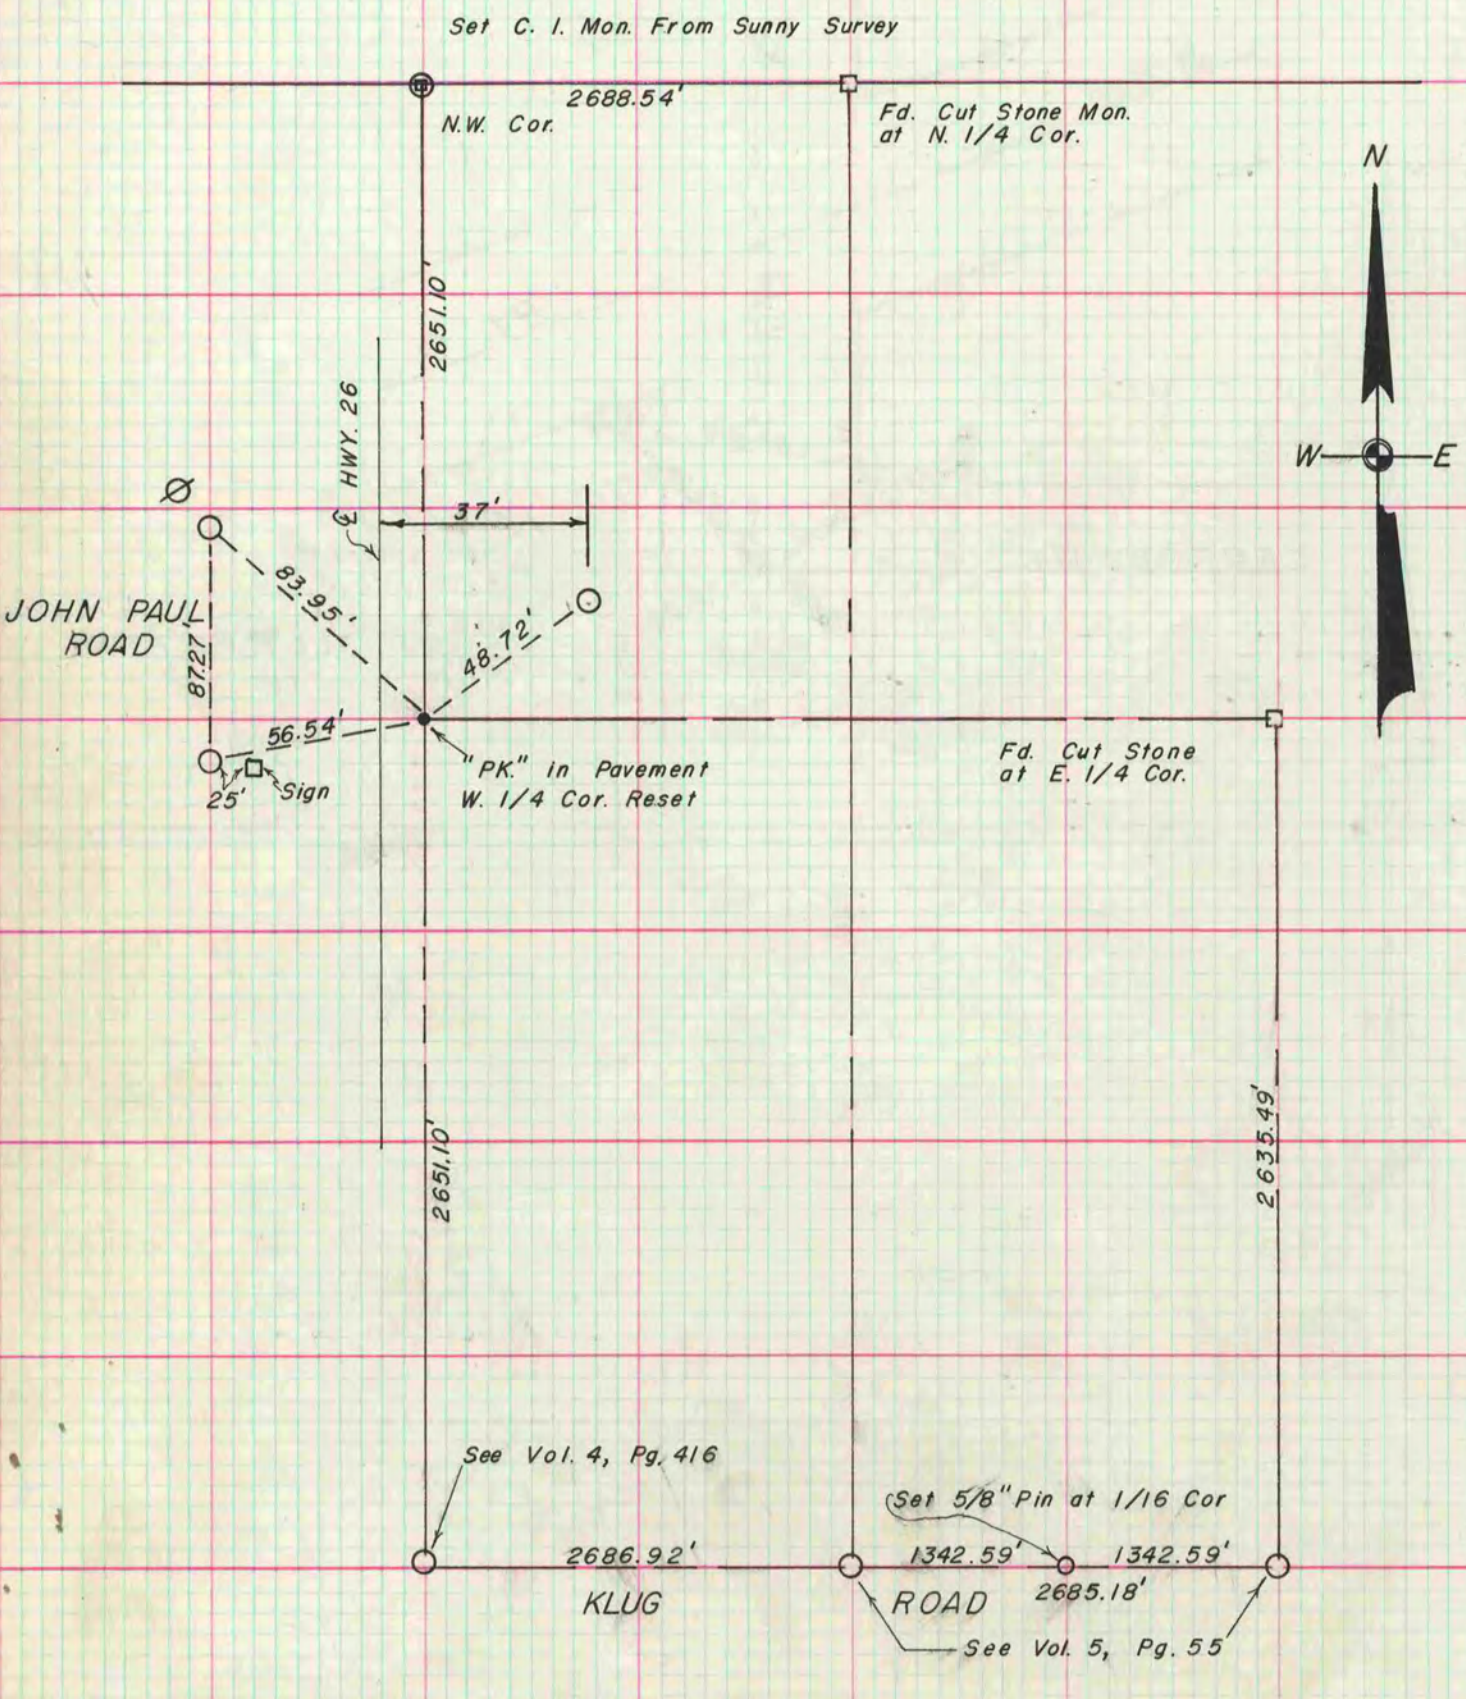

The Sec. Corner Data Hereon
By: R.H. Batterman & Co. Inc.
Ord. No 13463