


# PLAT AND RECORD

COUNTY BUILDING  
CITY OF JANESVILLE

Of a Survey on Section 31 T 1 R 12 E. of the 4 P. M. in BELOIT Township

Rock County, Wisconsin, made FEBRUARY the 26


I hereby certify that the following is a correct record of said survey as made by me.

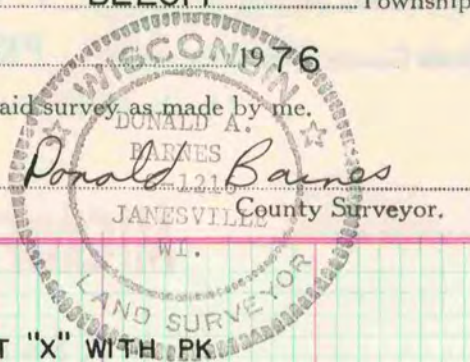

**MICROFILMED**

NE COR SEC 31

FOUND CUT "X" WITH PK

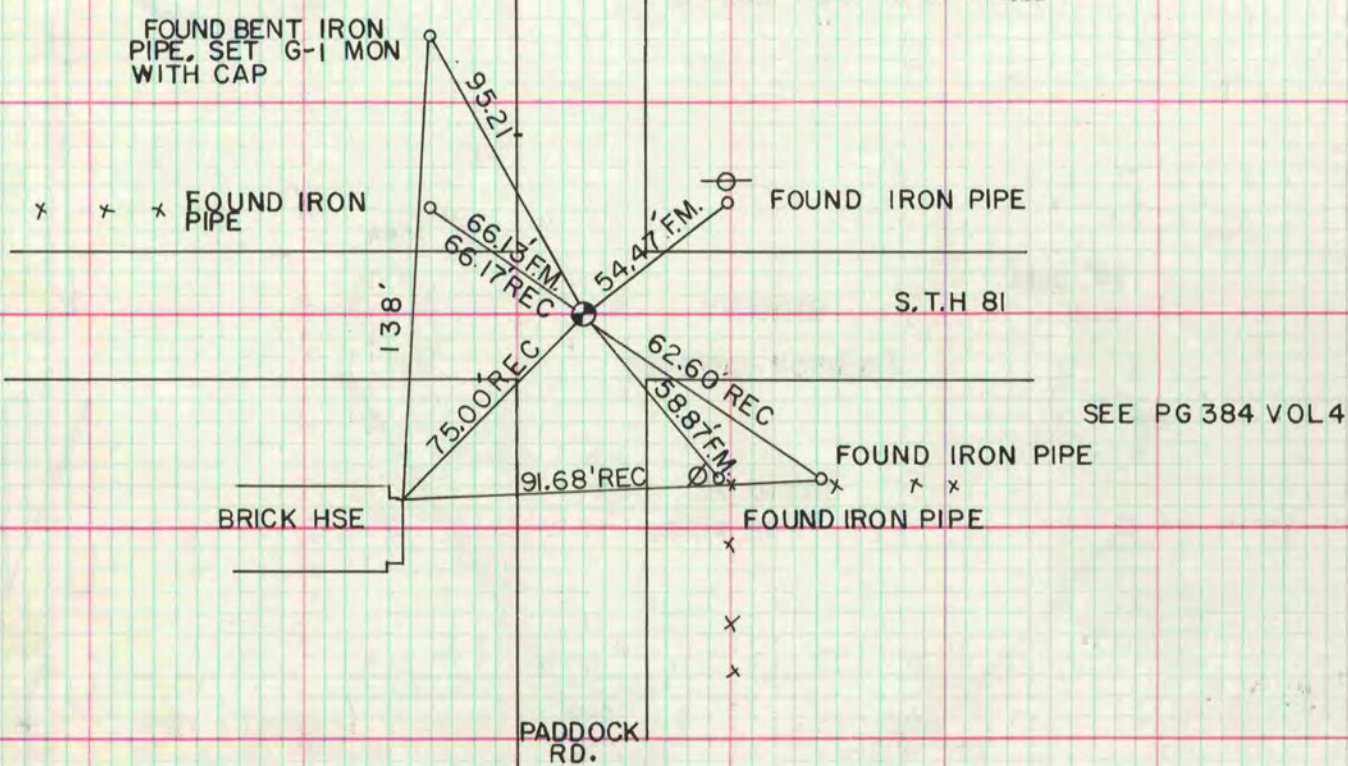

N 1/4 COR SEC 31

