

✓-2 MICROFILMED


# PLAT AND RECORD

Of a Survey on Section 24 T 3 R 12 E. of the 4 P. M. in *Janesville* Township  
Rock County, Wisconsin, made the 19

I hereby certify that the following is a correct record of said survey as made by me.

COUNTY BUILDING  
CITY OF JANESVILLE

(Signed) *Perry F. Brown*  
R.H.B. County Surveyor.

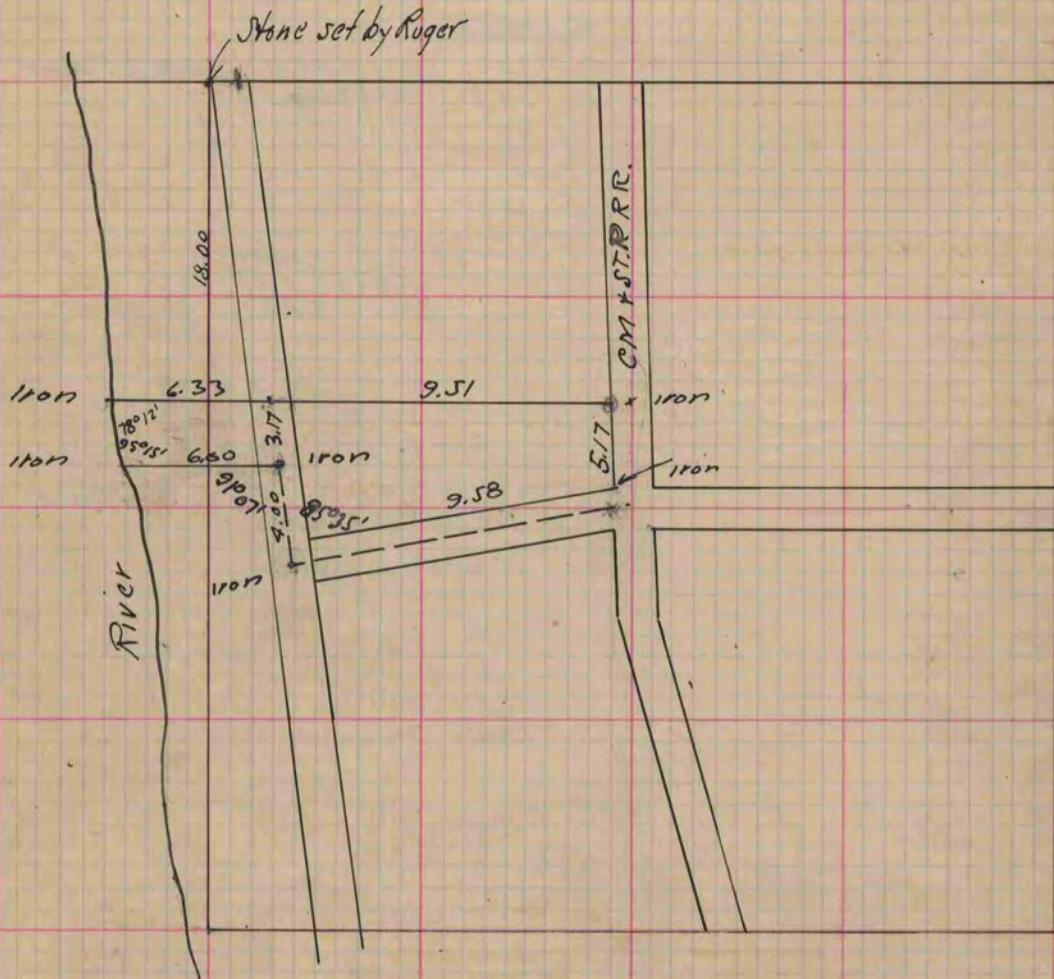

Copied from P. 385 Vol. 2 County Surveyors Record.