


# PLAT AND RECORD

Of a Survey on Section 5 T 1 R 14 E. of the 4 P. M. in Clinton Township  
Rock County, Wisconsin, made June the 14 1878

I hereby certify that the following is a correct record of said survey as made by me.

COUNTY BUILDING  
CITY OF JANESVILLE

(Signed) Edward Ruger  
R.H.B. County Surveyor.

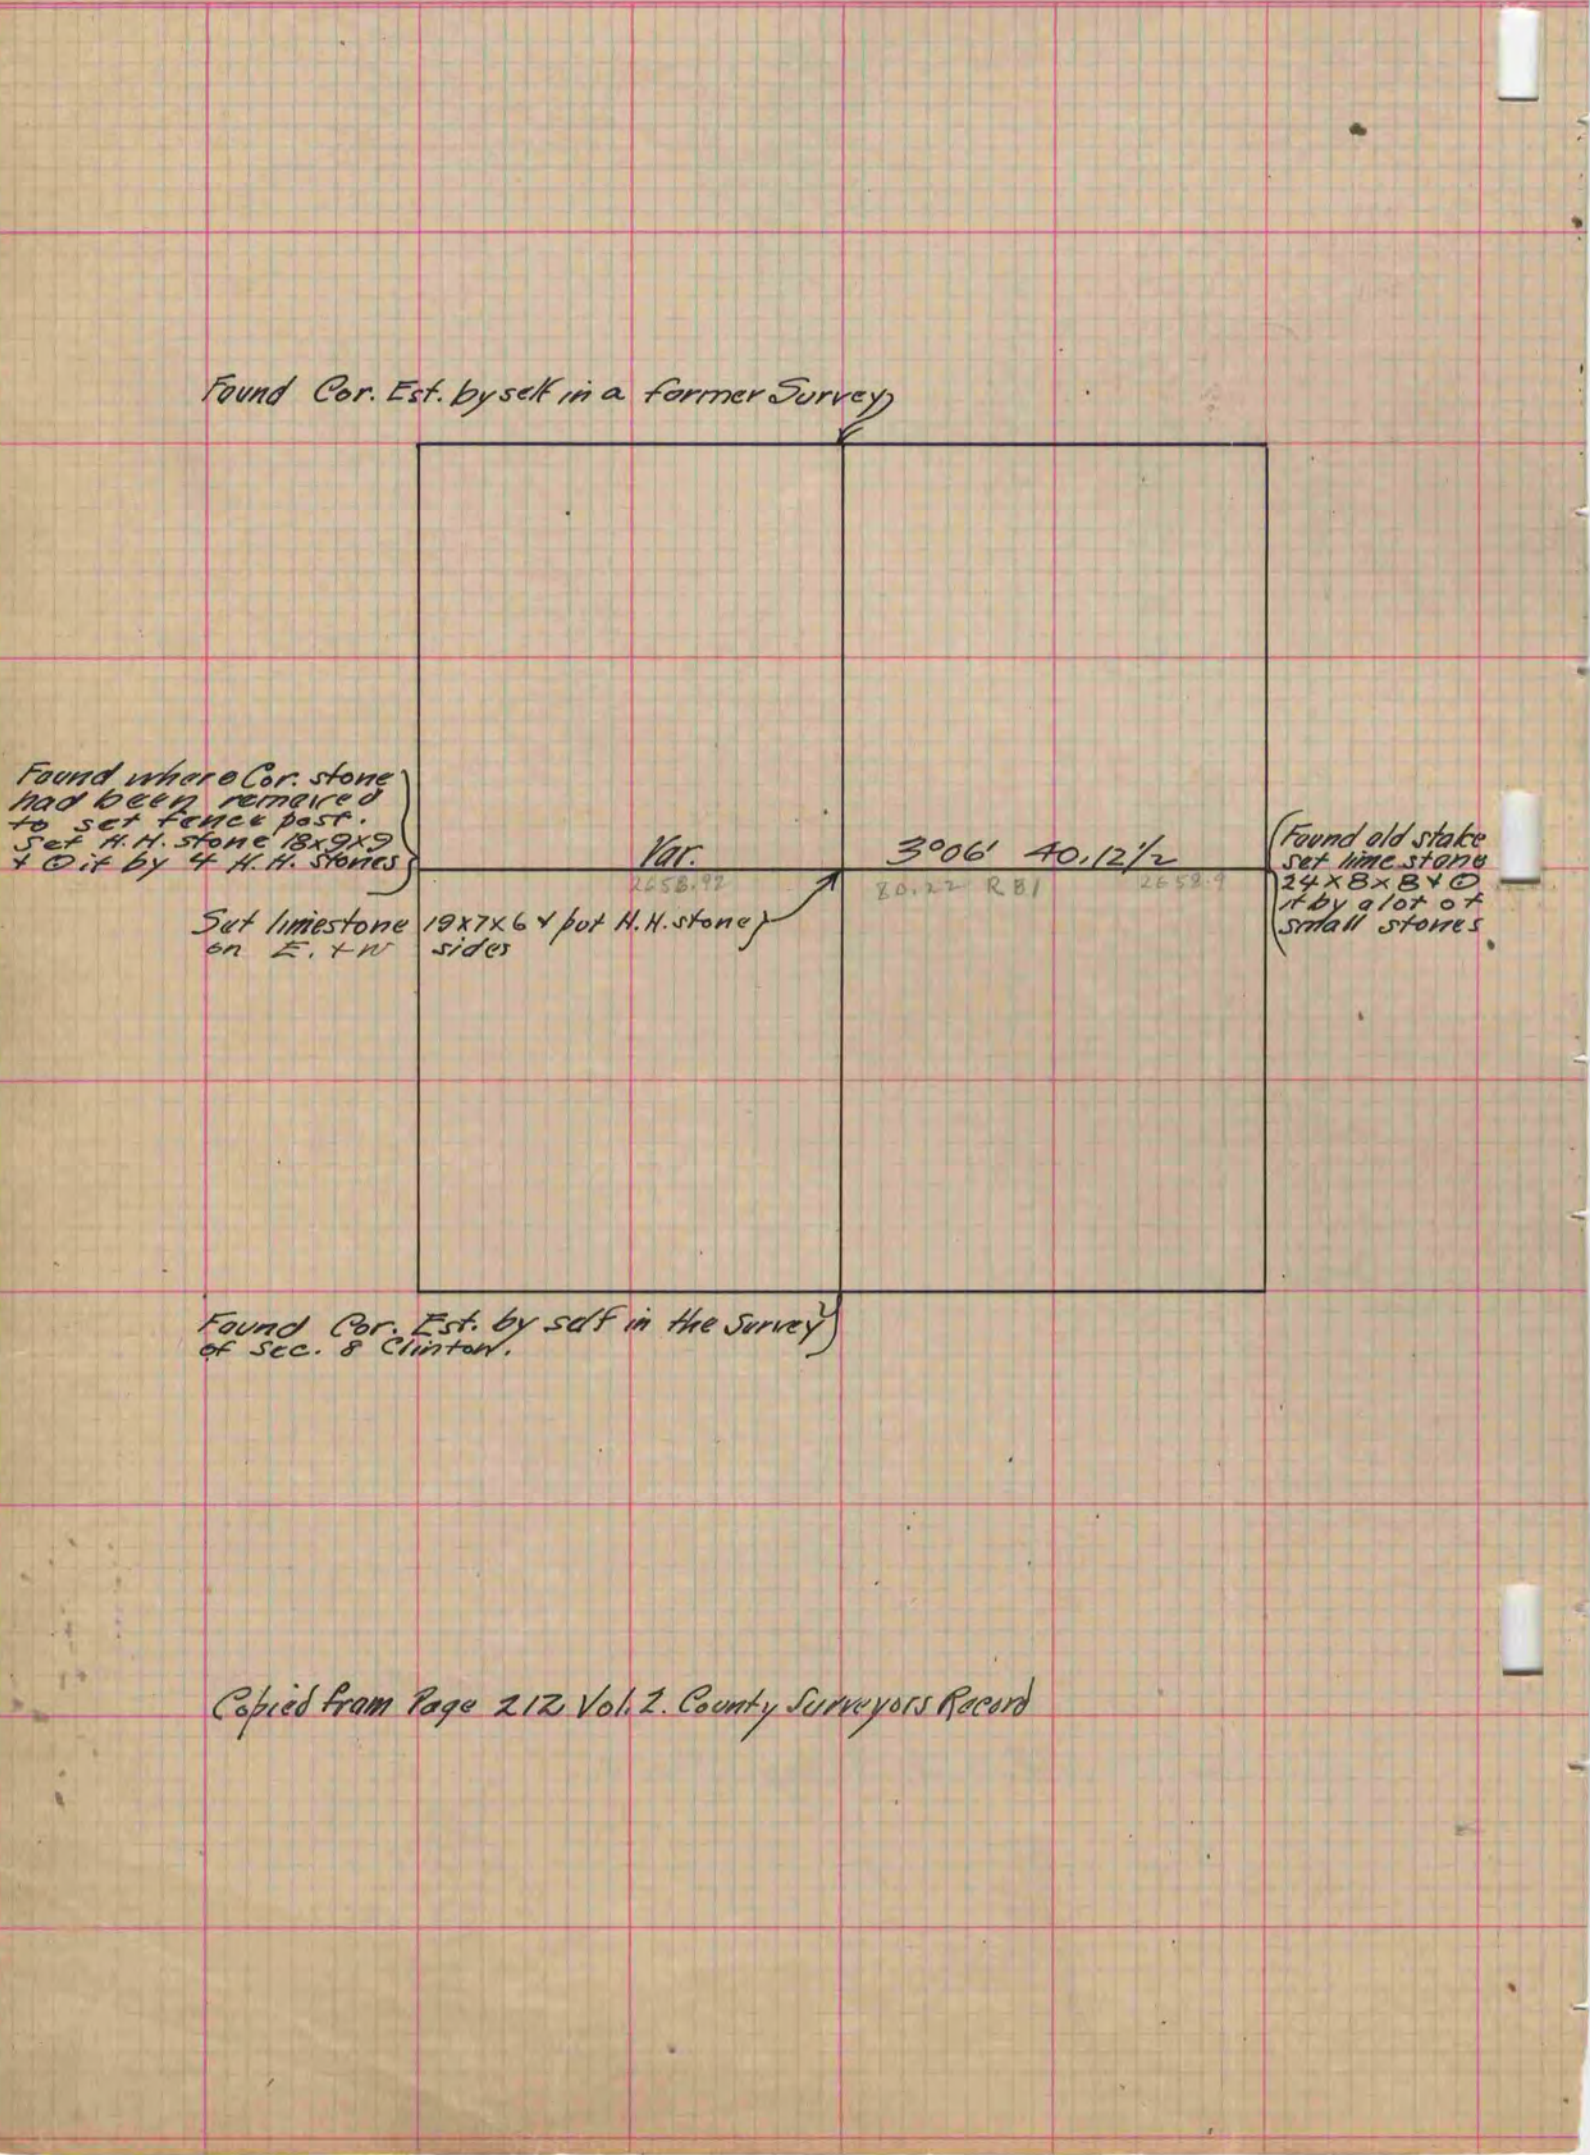

Copied from Page 212, Vol. 2, County Surveyors Record