

PLAT AND RECORD

MICROFILMED

COUNTY BUILDING
CITY OF JANESVILLE


Of a Survey on Section 25 T 2 R 12 E. of the 4 P. M. in Rock Township

Rock County, Wisconsin, made May the 13th, 14th, & 18th 1873

I hereby certify that the following is a correct record of said survey as made by me.

(Signed) R. K. Lee
R. H. B.

Dep.
County Surveyor.

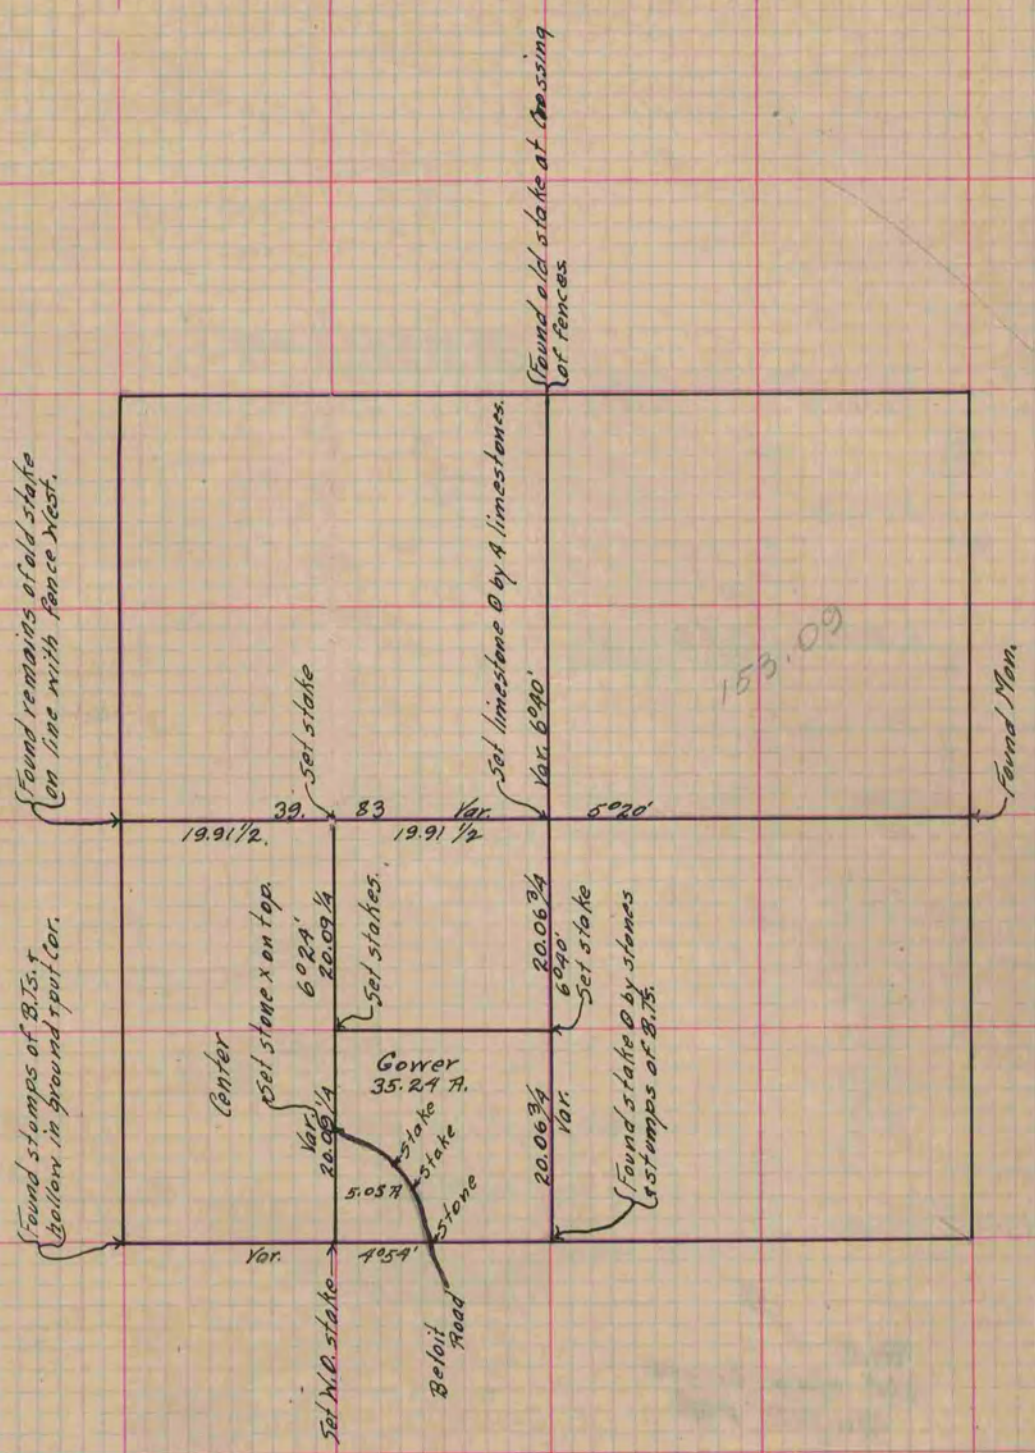

Copied from Page 57 Vol. 2 Original County Surveyor's Record.