

# PLAT AND RECORD

**MICROFILMED**


Of a Survey on Section 15 T 3 R 10 E. of the 4 P. M. in Magnolia Township  
Rock County, Wisconsin, made January the 12 & 13 1871

I hereby certify that the following is a correct record of said survey as made by me.

COUNTY BUILDING  
CITY OF JANESVILLE

(Signed) Edward Ruger  
R.H.B.

County Surveyor

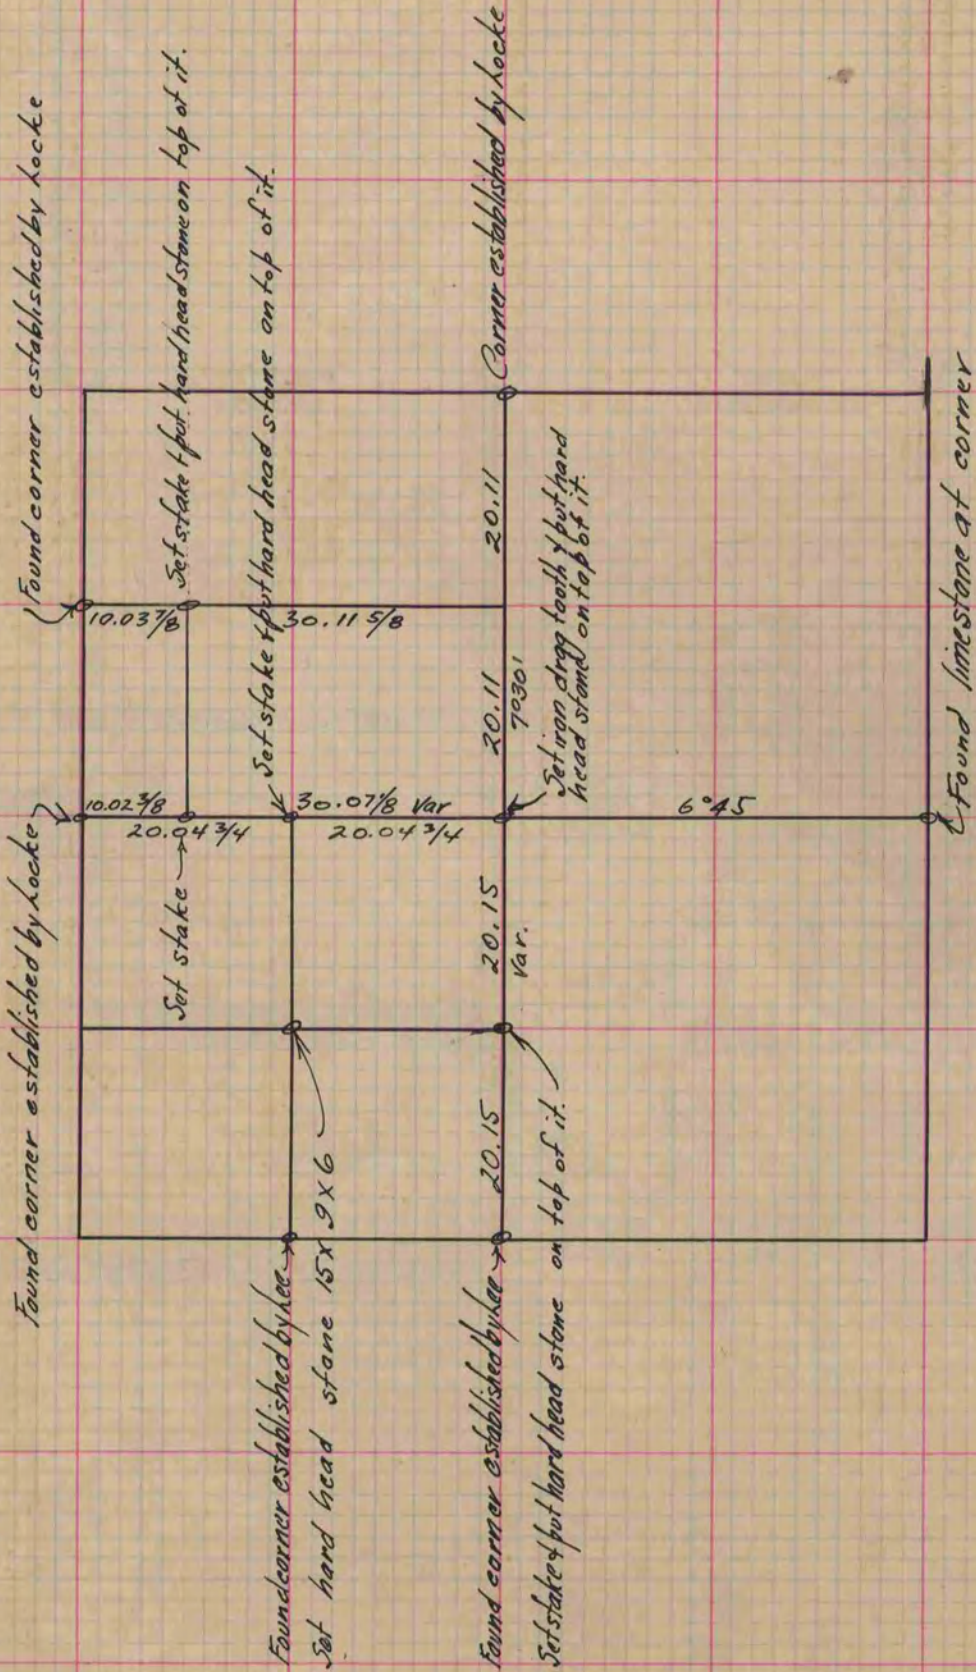

Copied from lower part of page 33 Vol. 12. Original County Surveyors Record