

MICROFILMED

PLAT AND RECORD


Of a Survey on Section 7 T 4 R 10 E. of the 4 P. M. in Union Township

Rock County, Wisconsin, made December the 20, 21 & 22 1870

I hereby certify that the following is a correct record of said survey as made by me.

COUNTY BUILDING
CITY OF JANESVILLE

(Signed) Edward Ruger { Deputy
R. H. B. County Surveyor

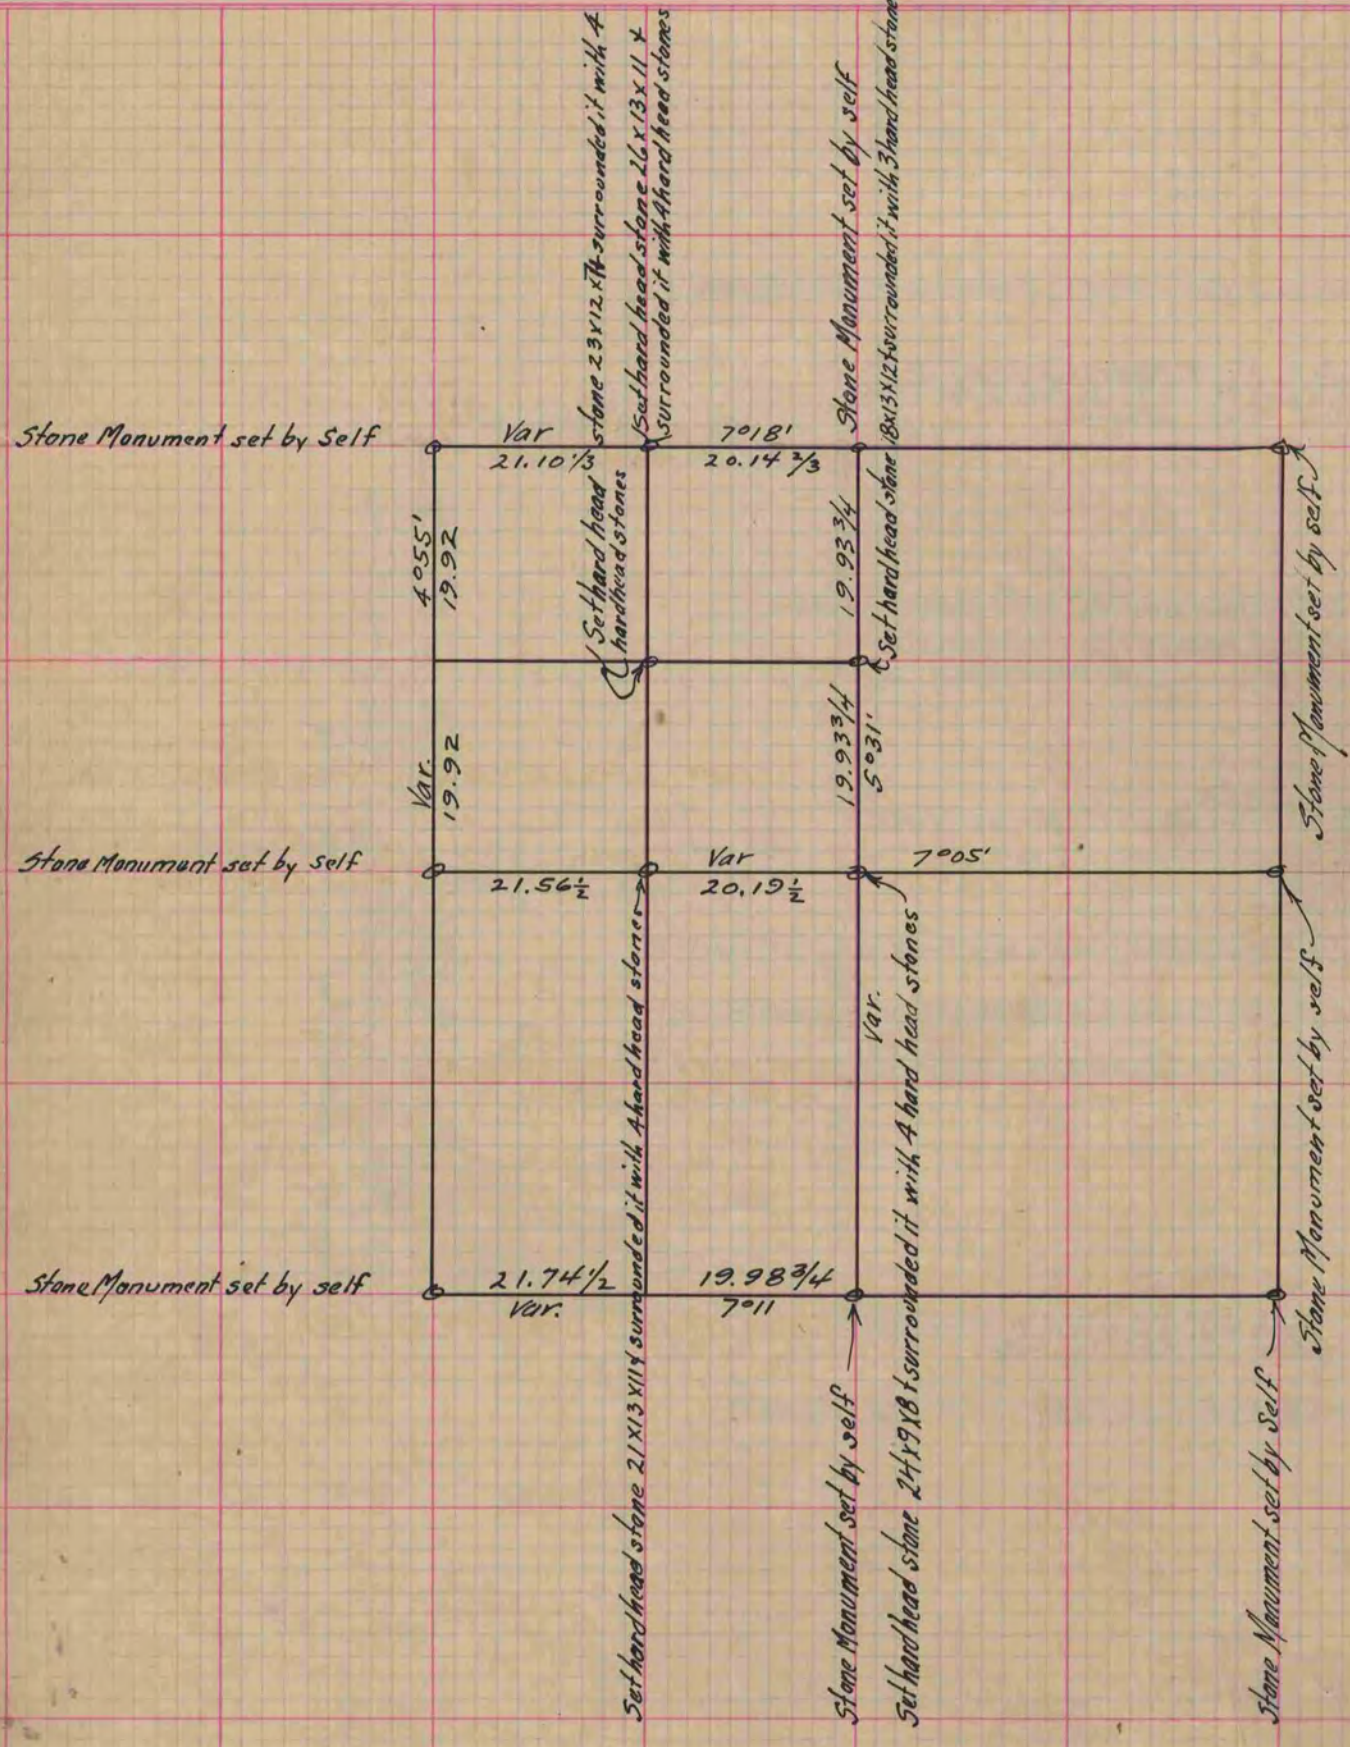

Copied from page 32 Vol. 2. Original County Surveyors Record