

MICROFILMED

PLAT AND RECORD

51  
V-2

COUNTY BUILDING  
CITY OF JANESVILLE


Of a Survey on Section 3 T 3 R 14 E. of the 4 P. M. in Johnstown Township

Rock County, Wisconsin, made December the 26 + 27 1870

I hereby certify that the following is a correct record of said survey as made by me.

COUNTY BUILDING  
CITY OF JANESVILLE

(Signed) Edward Ruger { Deputy  
R.H.B. County Surveyor.

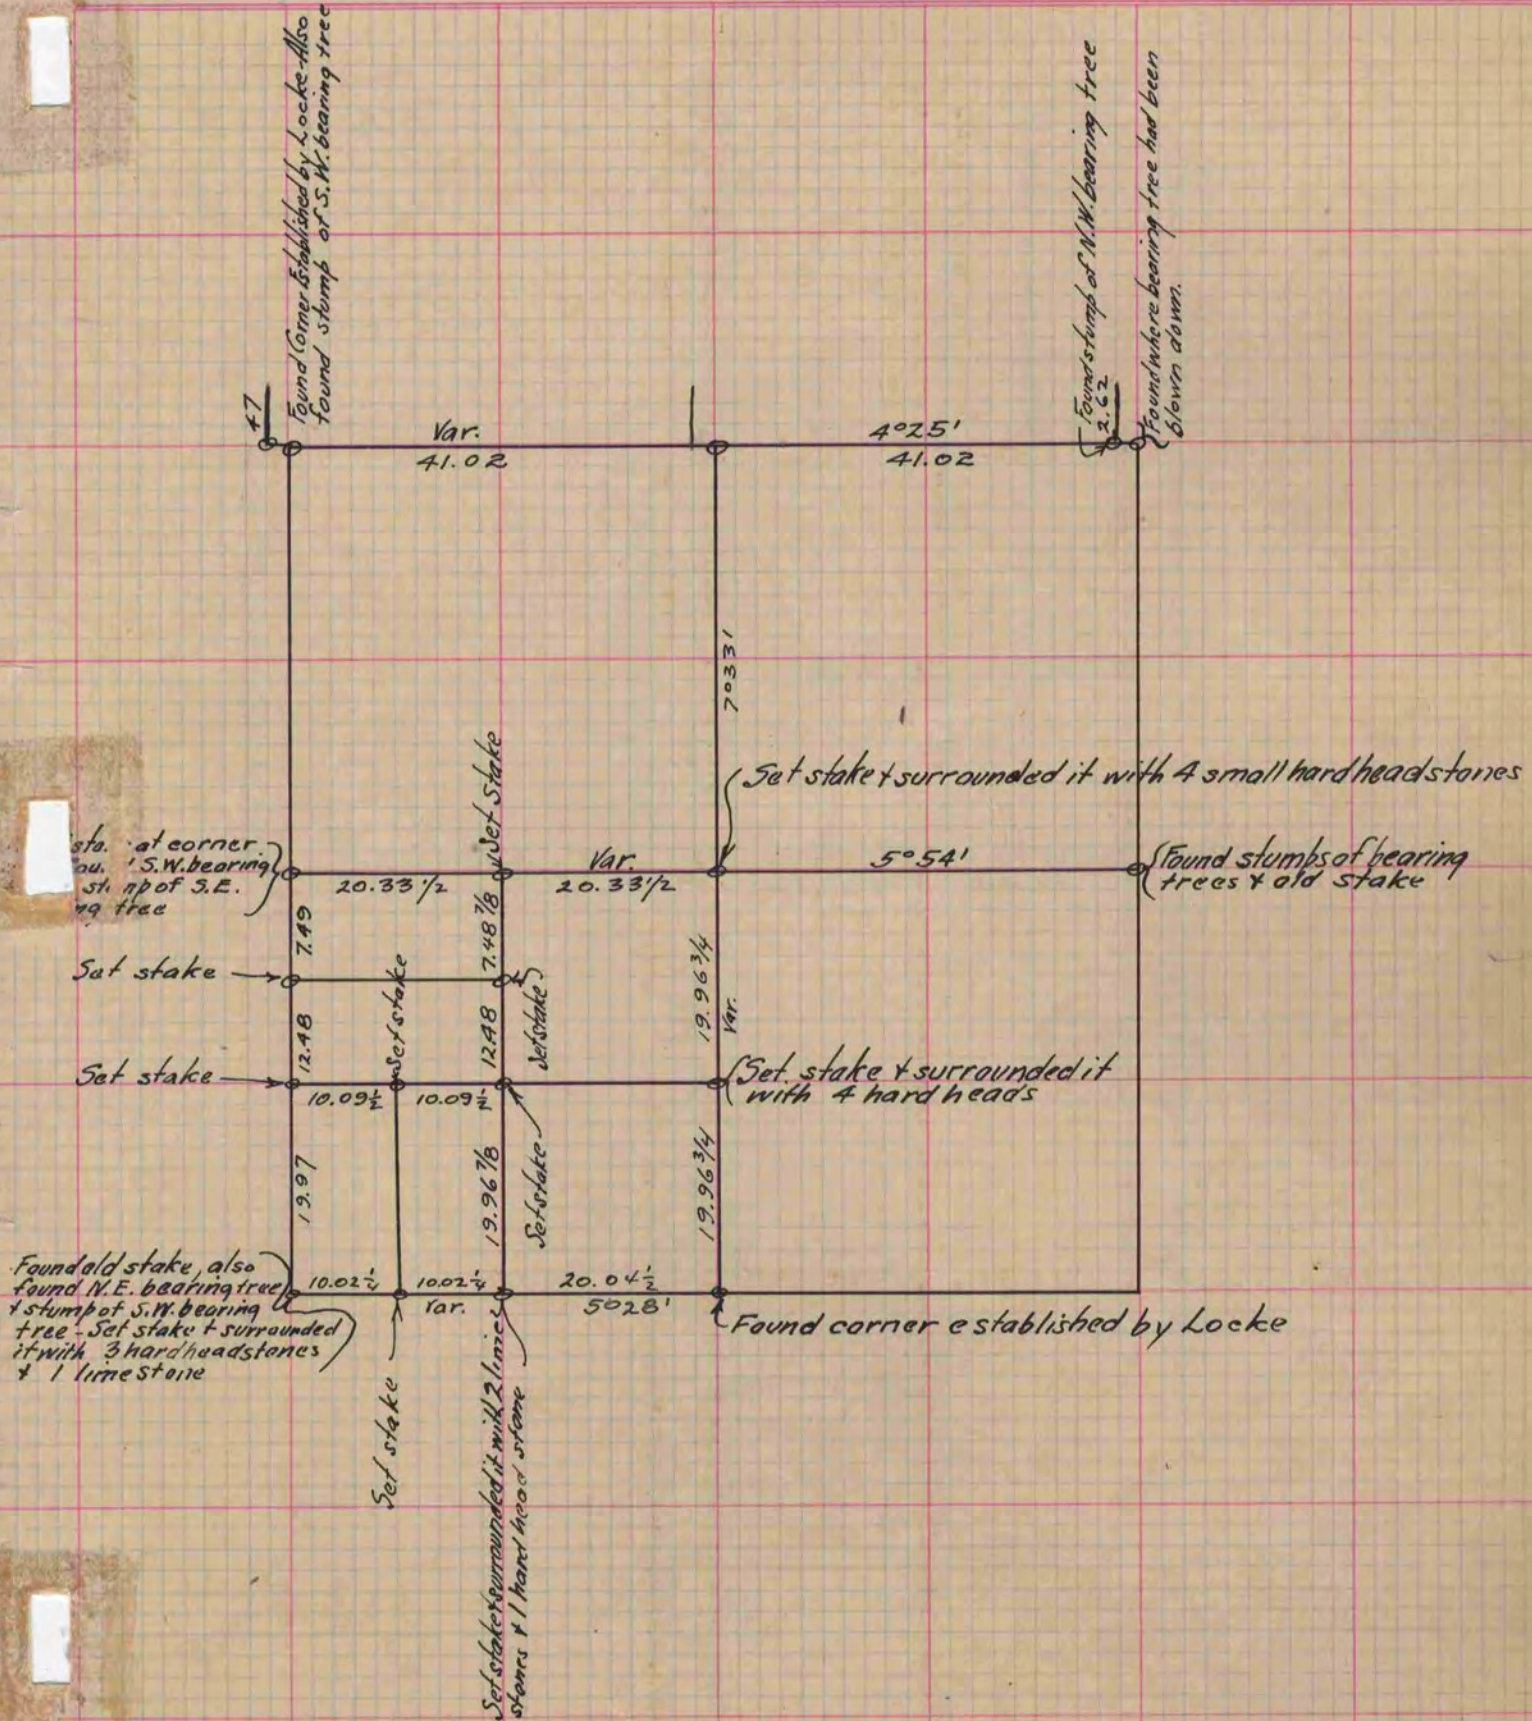

Copied from Page 33 Vol. 2 Original County Surveyors Record