

PLAT AND RECORD

COUNTY BUILDING
CITY OF JANESVILLE


MICROFILMED

Of a Survey on Section 24 T 1 R 13 E. of the 4 P. M. in Turtle Township

Rock County, Wisconsin, made August the 29 + 30 1876

I hereby certify that the following is a correct record of said survey as made by me.

(Signed) Edward Ruger
R.H.B. County Surveyor.

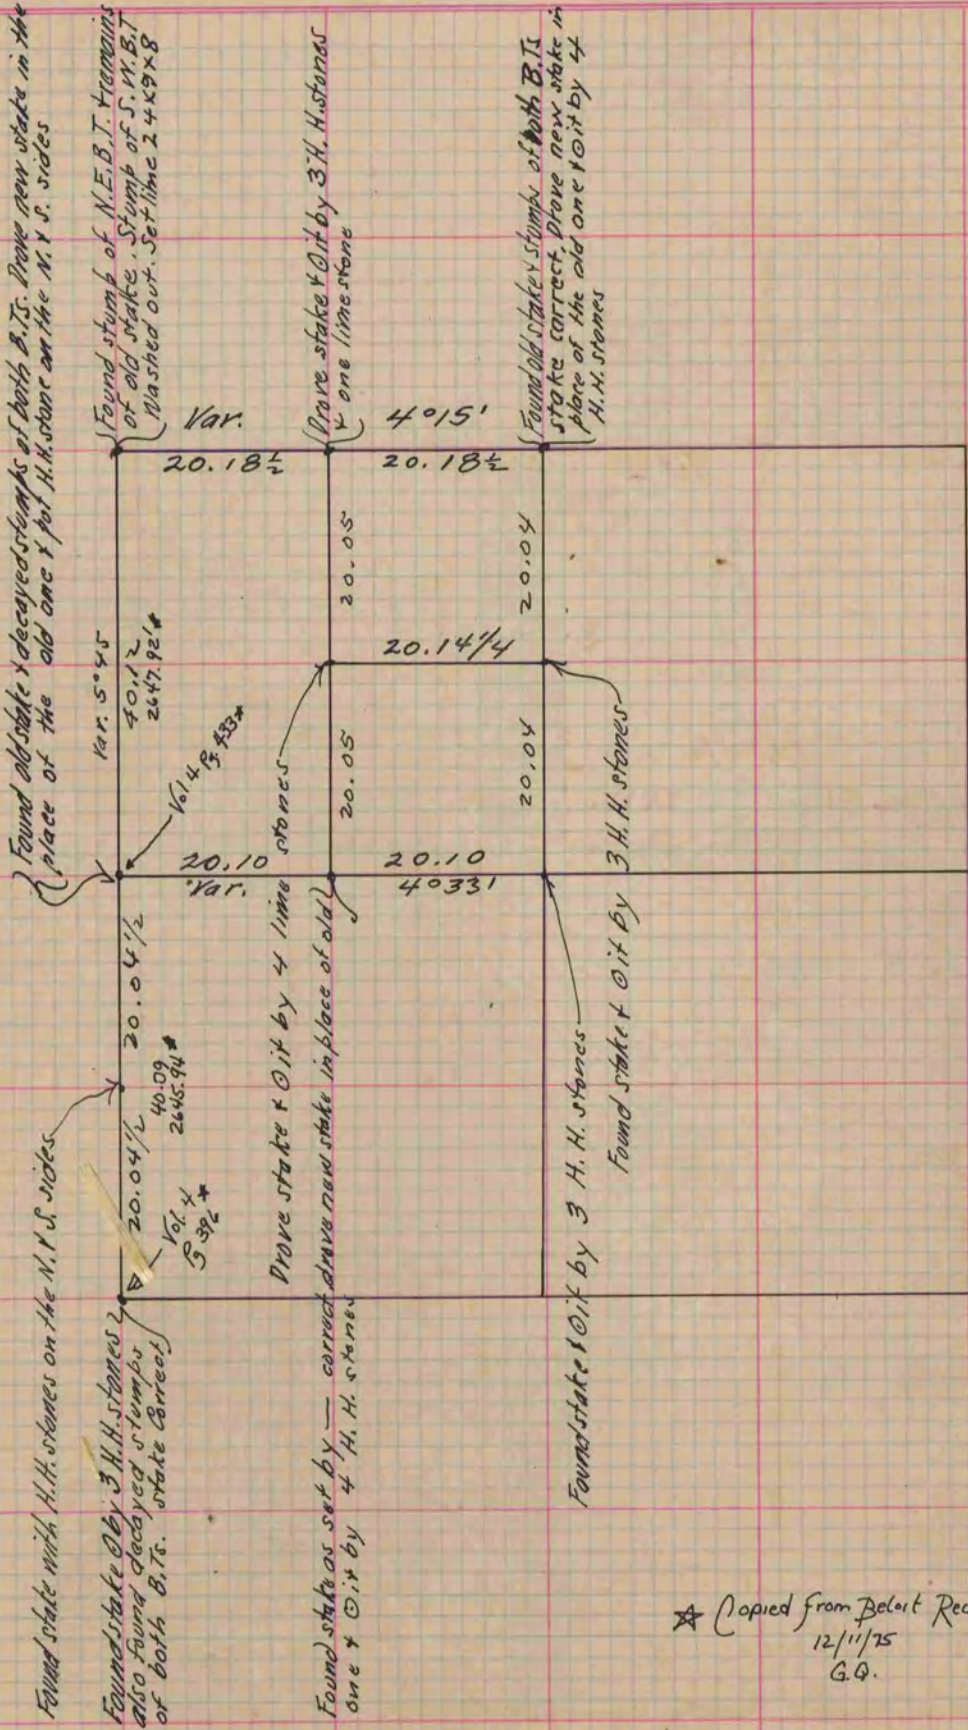

★ Copied from Deloit Records
12/11/75
G.Q.

Copied from page 169 Vol. 2. County Surveyor's Record.