

MICROFILMED


PLAT AND RECORD

COUNTY BUILDING
CITY OF JANESVILLE

Of a Survey on Section 12 T 2 R 11 E. of the 4 P. M. in Plymouth Township
Rock County, Wisconsin, made February the 25 & 26 1876

I hereby certify that the following is a correct record of said survey as made by me.

(Signed) Edward Ruger
R. H. B. County Surveyor.

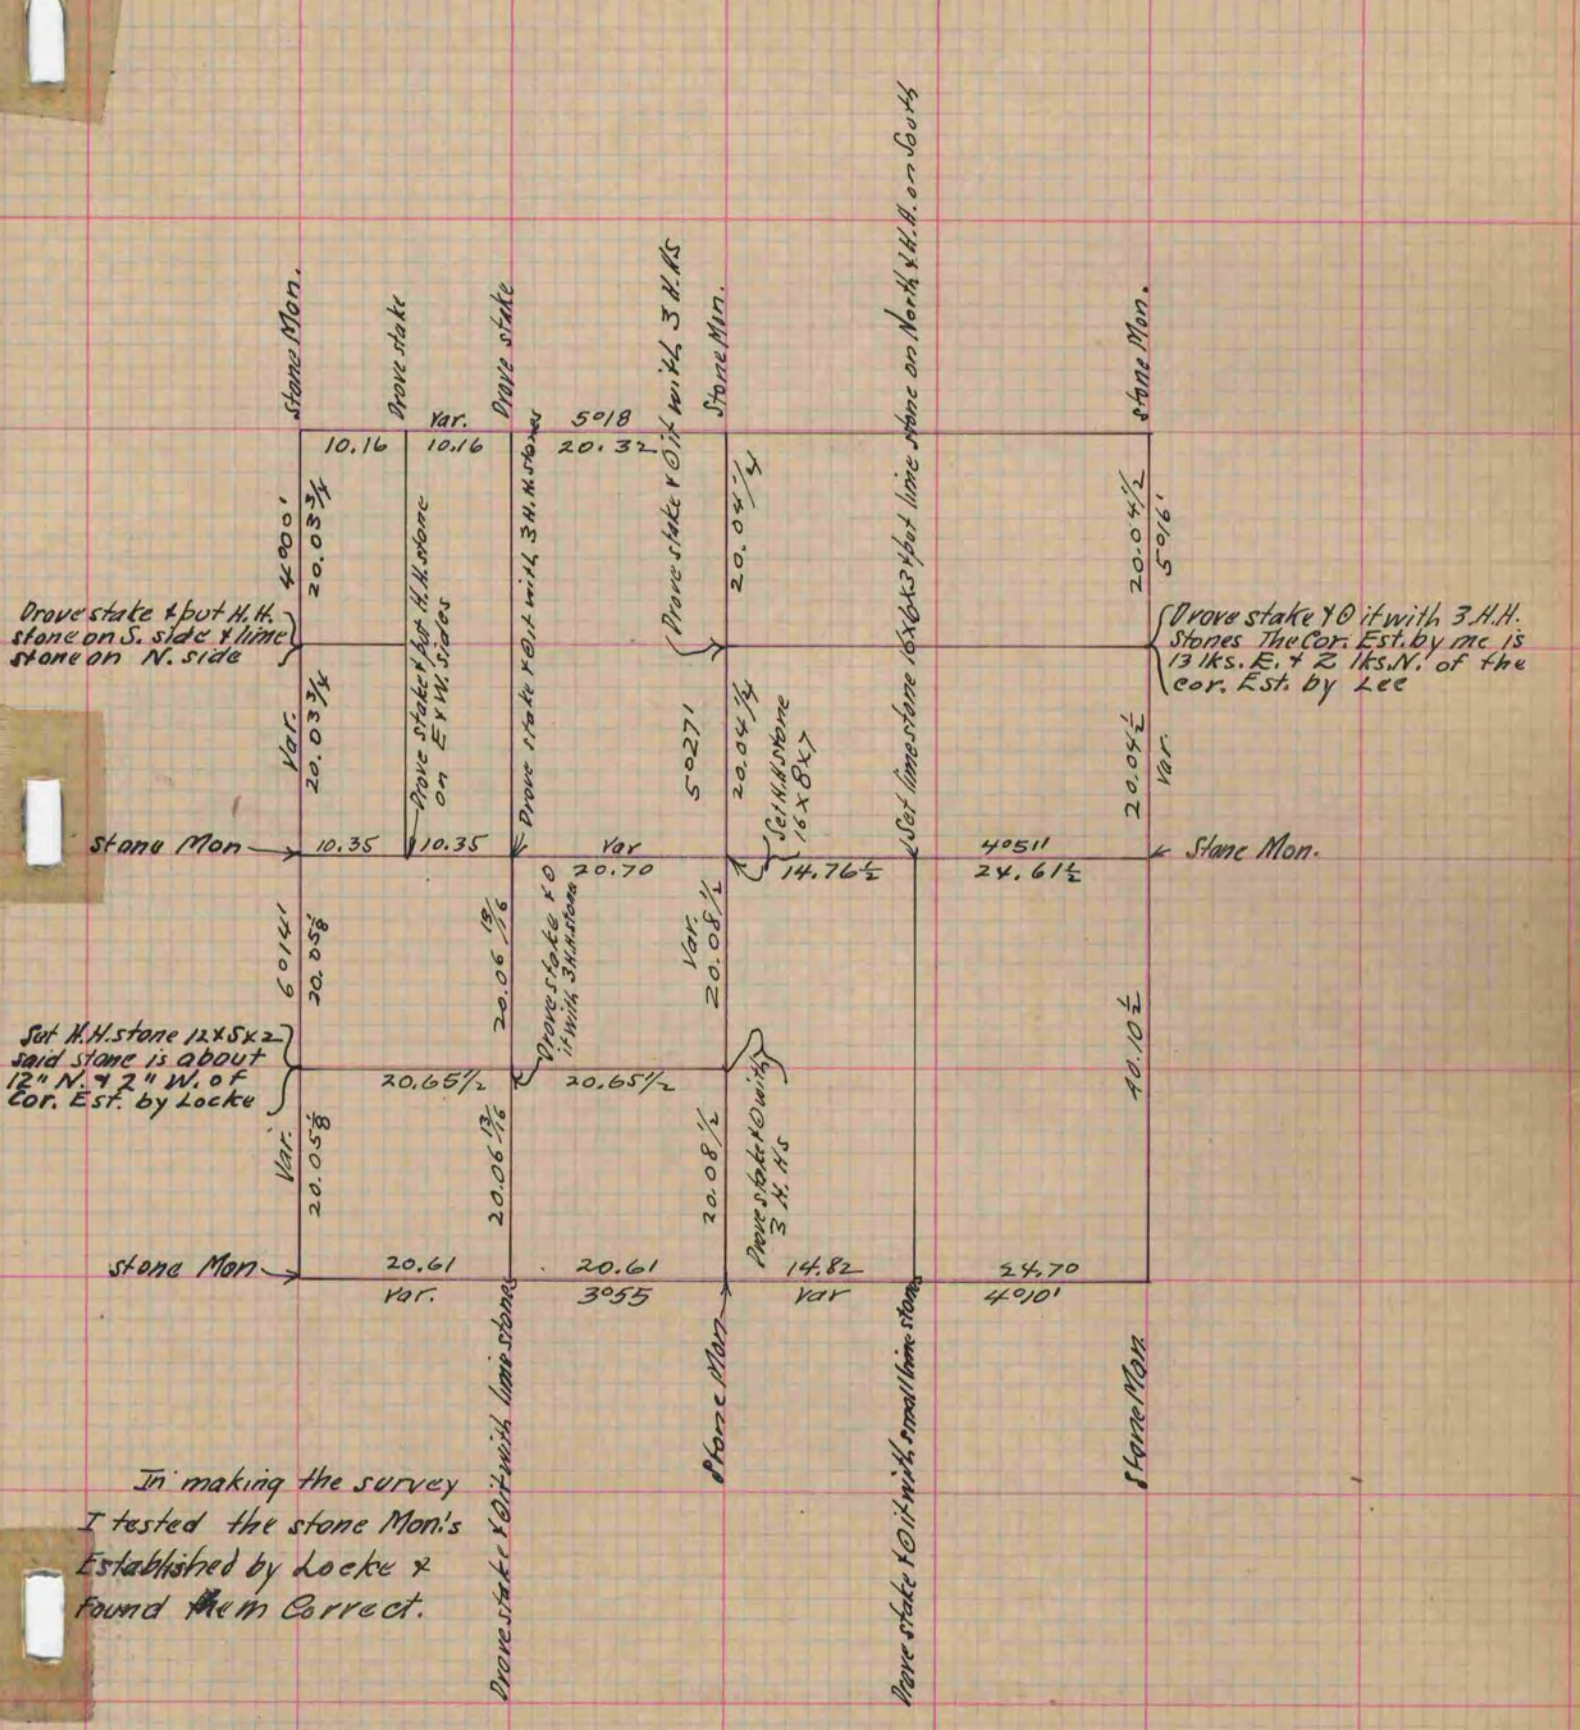

Copied from P. 159 Vol. 2 County Surveyors Record